

CARD MUST BE TYPED

State of Kansas
NOTICE OF INTENTION TO DRILL

CARD MUST BE SIGNED

(see rules on reverse side)

Starting Date: Nov. 26 84
month day year

API Number 15- 095-20,021-A-0001

OPERATOR: License # 9533
Name Fairchild Exploration
Address R.R. 3
City/State/Zip Kingman, Kansas 67068
Contact Person Bob G. Fairchild
Phone 316.532.3047

Sec 26, Twp 28. S, Rge. 8
C. NE. NE (location)

4620 Ft North from Southeast Corner of Section
660 Ft West from Southeast Corner of Section
(Note: Locate well on Section Plat on reverse side)

CONTRACTOR: License # 5842
Name Gabbert & Jones, Inc.
City/State Wichita, Kansas

Nearest lease or unit boundary line 660 feet
County Kingman

Lease Name Martha Simons Well# 1

Domestic well within 330 feet: yes no

Municipal well within one mile: yes no

Well Drilled For: Well Class: Type Equipment:

Oil Swd Infield Mud Rotary

Gas Inj Pool Ext. Air Rotary

OWWO Expl Wildcat Cable

Depth to Bottom of fresh water 105 feet

Lowest usable water formation

Depth to Bottom of usable water 218 feet

Surface pipe by Alternate: 1 2

Surface pipe ~~to be~~ set 218 feet

Conductor pipe if any required

Ground surface elevation 1677 feet MSL

This Authorization Expires 5-9-85

Approved By 11-9-84

If OWWO: old well info as follows:

Operator Kaiser-Francis, Lario, Leben

Well Name #1 Martha Simons

Comp Date O+A 5/4/67... Old Total Depth 4525

Projected Total Depth 4525 feet

Projected Formation at TD Simp

Expected Producing Formations MISS. GHT

I certify that we will comply with K.S.A. 55-101, et seq., plus eventually plugging hole to K.C.C. specifications.


Date 11/9/84 Signature of Operator or Agent Bob G. Fairchild Title Owner

Must be filed with the K.C.C. five (5) days prior to commencing well
 This card void if drilling not started within six (6) months of date received by K.C.C.

Wichita, Kansas
 CONSERVATION DIVISION

NOV 09 1984

A Regular Section of Land
 1 Mile = 5,280 Ft.
 SECTION

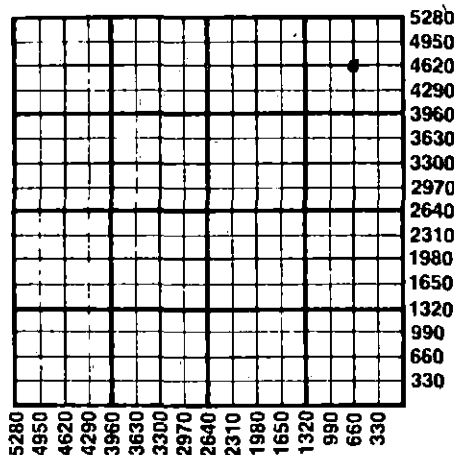

Important procedures to follow :

1. Notify District office before setting surface casing.
2. Set surface casing by circulating cement to the top.
3. File completion forms ACO-1 with K.C.C. within 90 days of well completion, following instructions on ACO-1, side 1, and including copies of wireline logs.
4. Notify District office 48 hours prior to old well workover or re-entry.
5. Prior to plugging, prepare a plugging plan, then obtain agreement from the appropriate district office for an approved plugging plan.
6. Submit plugging report (CP-4) to K.C.C. after plugging is completed.
7. Obtain an approved injection docket number before disposing of salt water.
8. Notify K.C.C. within 10 days when injection commences or terminates.
9. If an alternate 2 completion, cement in the production pipe from below any usable water to surface within 120 days of spud date.

State Corporation Commission of Kansas
 Conservation Division
 200 Colorado Derby Building
 Wichita, Kansas 67202
 (316) 263-3238