

CARD MUST BE TYPED

State of Kansas
NOTICE OF INTENTION TO DRILL

CARD MUST BE SIGNED

(see rules on reverse side)

Starting Date: 12 30 84
month day year

API Number 15- 095-21,513-0000

OPERATOR: License # 5171

NW SW SW... Sec 30 Twp 28 S, Rge 10. East West
(location)

Name TXO Production Corp.

Address 200 W. Douglas, Suite 300

City/State/Zip Wichita, KS 67202

Contact Person Gary Wurdeman

Phone 316-265-9441

990 Ft North from Southeast Corner of Section

4950 Ft West from Southeast Corner of Section

(Note: Locate well on Section Plat on reverse side)

CONTRACTOR: License # 5107

Name H-30 Drilling, Inc.

City/State Wichita, KS 67202

Nearest lease or unit boundary line 330 feet.

County Kingman

Lease Name DeWEESE "A" Well# 1

Domestic well within 330 feet: yes no

Municipal well within one mile: yes no

Well Drilled For: Well Class: Type Equipment:

Oil Swd Infield Mud Rotary

Gas Inj Pool Ext. Air Rotary

OWWO Expl Wildcat Cable

Depth to Bottom of fresh water 100 190 mth feet

Lowest usable water formation Nippewalla Group

Depth to Bottom of usable water 200 feet

Surface pipe by Alternate: 1 2

Surface pipe to be set 400 feet

Conductor pipe if any required 0 feet

Ground surface elevation 1789 feet MSL

If OWWO: old well info as follows:

Operator

Well Name

Comp Date Old Total Depth

Projected Total Depth 2870 feet

Projected Formation at TD Tarkio Sand

Expected Producing Formations Tarkio Sand

This Authorization Expires 6-19-85

Approved By 12-19-84

I certify that we will comply with K.S.A. 55-101, et seq., plus eventually plugging hole to K.C.C. specifications.

Date 12-18-84 Signature of Operator or Agent

Gary Wurdeman

District Engineer

Form C-1 4/84

mhc/KOHE 12/19/84

Must be filed with the K.C.C. five (5) days prior to commencing well
This card void if drilling not started within six (6) months of date received by K.C.C.

CONSERVATION DIVISION
Wichita, Kansas
7854


DEC 19 1984

12-9-84

Important procedures to follow:

1. Notify District office before setting surface casing.
2. Set surface casing by circulating cement to the top.
3. File completion forms ACO-1 with K.C.C. within 90 days of well completion, following instructions on ACO-1, side 1, and including copies of wireline logs.
4. Notify District office 48 hours prior to old well workover or re-entry.
5. Prior to plugging, prepare a plugging plan, then obtain agreement from the appropriate district office for an approved plugging plan.
6. Submit plugging report (CP-4) to K.C.C. after plugging is completed.
7. Obtain an approved injection docket number before disposing of salt water.
8. Notify K.C.C. within 10 days when injection commences or terminates.
9. If an alternate 2 completion, cement in the production pipe from below any usable water to surface within 120 days of spud date.

RECEIVED
MAY 28 1984
STATE OF KANSAS
A Regular Section of Land
COMMISSION

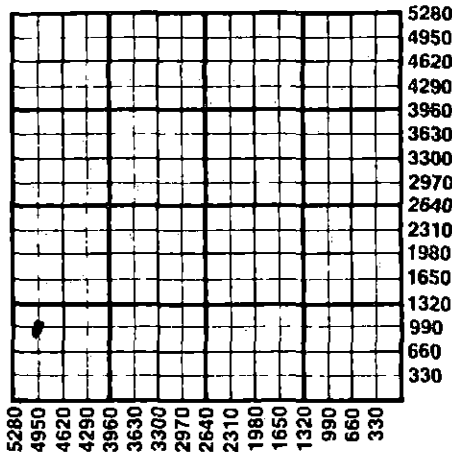

State Corporation Commission of Kansas
Conservation Division
200 Colorado Derby Building
Wichita, Kansas 67202
(316) 263-3238