

STATE OF KANSAS
STATE CORPORATION COMMISSION


Form CP-4

WELL PLUGGING RECORD

Give All Information Completely
Make Required Affidavit
Mail or Deliver Report to:
Conservation Division
State Corporation Commission
211 No. Broadway
Wichita, Kansas

Kingman County. Sec. 8 Twp. 29S Rge. (E) 7 (W)
Location as "NE/CNW%SW%" or footage from lines C NW SE
Lease Owner Pickrell Drilling Company
Lease Name Rosenkranz No. 1 Well No. 1
Office Address 705 4th National Bank Bldg, Wichita, Kansas
Character of Well (completed as Oil, Gas or Dry Hole) Dry Hole
Date well completed April 13, 19 65
Application for plugging filed April 13, 19 65
Application for plugging approved April 13, 19 65
Plugging commenced April 13, 19 65
Plugging completed April 13, 19 65
Reason for abandonment of well or producing formation Dry Hole

NORTH

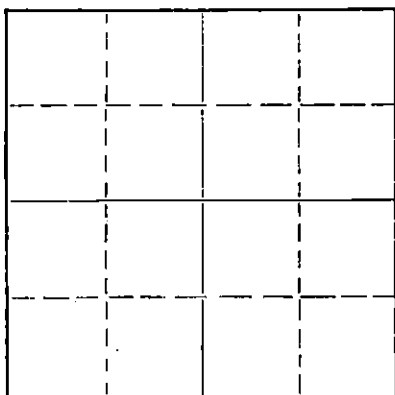

Locate well correctly on above
Section Plat

If a producing well is abandoned, date of last production 19
Was permission obtained from the Conservation Division or its agents before plugging was com-
menced? Yes

Name of Conservation Agent who supervised plugging of this well Archie V. Elving
Producing formation _____ Depth to top _____ Bottom _____ Total Depth of Well 4273 Feet
Show depth and thickness of all water, oil and gas formations.

OIL, GAS OR WATER RECORDS

CASING RECORD

FORMATION	CONTENT	FROM	TO	SIZE	PUT IN	PULLED OUT
				8 5/8"	217'	None

Describe in detail the manner in which the well was plugged, indicating where the mud fluid was placed and the method or methods used in introducing it into the hole. If cement or other plugs were used, state the character of same and depth placed, from _____ feet to _____ feet for each plug set.

Heavy mud to 220', set plug, cemented with
25 sacks cement. Heavy mud to 40', set plug,
cemented with 10 sacks cement to bottom of
cellar. Plugged rat hole with 2 sacks cement.

RECEIVED
STATE CORPORATION COMMISSION

APR 23 1965
4-23-65

CONSERVATION DIVISION
Wichita, Kansas

(If additional description is necessary, use BACK of this sheet)

Name of Plugging Contractor Pickrell Drilling Company
Address 705 4th National Bank Bldg, Wichita, Kansas

STATE OF KANSAS, COUNTY OF SEDGWICK, ss.
C. W. SEBITS (owner or operator) of the above-described well, being first duly sworn on oath, says: That I have knowledge of the facts, statements, and matters herein contained and the log of the above-described well as filed and that the same are true and correct. So help me God.

(Signature) C. W. Sebits
705 4th National Bank Bldg, Wichita, Kansas
(Address)

SUBSCRIBED AND SWORN to before me this 20th day of April, 19 65

My commission expires June 21, 1966
Maxine Blackman Notary Public.

ROTARY DRILLING LOG

COMPANY: PICKRELL DRILLING COMPANY
705 4th National Bank Bldg.
Wichita, Kansas

Rotary Drilling Commenced 4--2-65

Rotary Drilling Completed 4-13-65

LOCATION: ROSENKRANZ No. 1, C NW SE Section 8-29-7W, Kingman County, Kansas

CONTRACTOR: **PICKRELL DRILLING COMPANY**
Wichita, Kansas

CASING RECORD: (10 jts) 8 5/8" surface casing set at 217' cemented with 165 sacks cement. Circulated. Completed 6:30 P.M. April 2, 1965. No oil string run, D & A.

LOG

(Figures indicate bottom of formation — measurements from top of rotary bushing.)

150	Sand	<u>C. F. S.</u>
480	Red Rock	3425
1180	Red Rock & Shale	3430
3321	Shale & Lime	3790
3400	Sand & Shale	3813
3933	Lime	3850
4182	Lime & Shale	4172
4272	Mississippi & RTD	4182
		4192
		4222
		4273

Slope Tests
2500
3000
3515

S. L. M.
3705
3993
4211

RECEIVED
STATE CORPORATION COMMISSION

APR 23 1965

CONSERVATION DIVISION
Wichita, Kansas

The undersigned, C. W. Sebitts, Attorney-in-Fact for PICKRELL DRILLING COMPANY, hereby certifies in behalf of said Company, that the above is a true and correct log of the formation encountered in drilling the above well as reflected by the Daily Drilling Reports.

PICKRELL DRILLING COMPANY
By *C. W. Sebitts*
C. W. Sebitts, Attorney-in-Fact

STATE OF KANSAS }
COUNTY OF SEDGWICK } ss.:

On this 20th day of April, 1965, before me the undersigned, a Notary Public, in and for the County and State aforesaid, personally appeared C. W. SEBITTS, to me known to be the identical person who subscribed the name of PICKRELL DRILLING COMPANY to the foregoing instrument as its Attorney-in-Fact and acknowledged to me that he executed the same as his free and voluntary act and deed, and as the free and voluntary act and deed of such company, for the uses and purposes therein set forth.

Given under my hand and seal of office the day and year last above written.

My commission expires: June 21, 1966.

Maxine Blackman
Maxine Blackman Notary Public