

15-095-00039-00-00

STATE OF KANSAS  
STATE CORPORATION COMMISSION

WELL PLUGGING RECORD

Give All Information Completely  
Make Required Affidavit  
Mail or Deliver Report to:  
Conservation Division  
State Corporation Commission  
211 No. Broadway  
Wichita, Kansas

KINGMAN County, Sec. 10 Twp. 29S Rge. 7W (E) X: (W)

Location as "NE/CNW/SW" or footage from lines C-SE-SW

Lease Owner PETROLEUM, INC.

Lease Name WRIGHT "F" Well No. 1

Office Address ROUTE # 2

Character of Well (completed as Oil, Gas or Dry Hole) DRY HOLE

Date well completed DECEMBER 29, 1961

Application for plugging filed DECEMBER 29, 1961

Application for plugging approved DECEMBER 29, 1961


Plugging commenced DECEMBER 29, 1961

Plugging completed DECEMBER 29, 1961

Reason for abandonment of well or producing formation NO PRODUCIBLE ZONES

If a producing well is abandoned, date of last production NONE 1961

Was permission obtained from the Conservation Division or its agents before plugging was commenced? YES

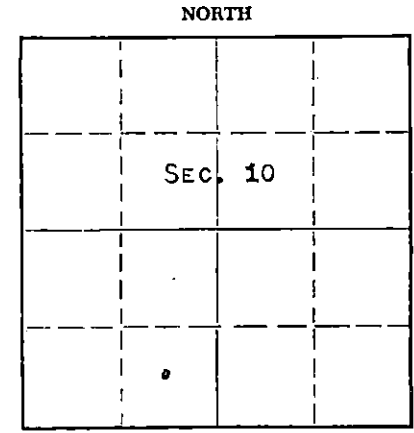

Locate well correctly on above Section Plot

Name of Conservation Agent who supervised plugging of this well FRED W. HAMPEL, PRETTY PRAIRIE, KANSAS

Producing formation \_\_\_\_\_ Depth to top \_\_\_\_\_ Bottom \_\_\_\_\_ Total Depth of Well 4590' Feet

Show depth and thickness of all water, oil and gas formations.

OIL, GAS OR WATER RECORDS

CASING RECORD

FORMATION	CONTENT	FROM	TO	SIZE	PUT IN	PULLED OUT
				8-5/8"	360'	NONE

Describe in detail the manner in which the well was plugged, indicating where the mud fluid was placed and the method or methods used in introducing it into the hole. If cement or other plugs were used, state the character of same and depth placed, from \_\_\_\_\_ feet to \_\_\_\_\_ feet for each plug set.

MUDDING UP WITH HEAVY MUD TO 300' FOLLOWED BY WOODEN PLUG AND 1/4 SACK HULLS. PLACED 20 SACKS CEMENT THROUGH DRILL PIPE ON TO HULLS. MUDDING UP WITH HEAVY MUD TO 40' FOLLOWED BY WOODEN PLUG, 1/4 SACK HULLS AND 10 SACKS CEMENT TO BASE OF WELL CELLAR.

RECEIVED  
STATE CORPORATION COMMISSION  
JAN 9 1962  
1-24-62  
CONSERVATION DIVISION  
Wichita, Kansas

(If additional description is necessary, use BACK of this sheet)

Name of Plugging Contractor GARVEY DRILLING COMPANY

Address ROUTE 2, GREAT BEND, KANSAS

STATE OF KANSAS, COUNTY OF BARTON, ss. DON SEARLE (employee of owner) or (owner or operator) of the above-described well, being first duly sworn on oath, says: That I have knowledge of the facts, statements, and matters herein contained and the log of the above-described well as filed and that the same are true and correct. So help me God. DON SEARLE, DIST. PROD. SUPT.

(Signature) Don Searle

ROUTE 2, GREAT BEND, KANSAS  
(Address)

SUBSCRIBED AND SWORN TO before me this 22ND day of JANUARY, 1962

My commission expires APRIL 14, 1963

Notary Public.



COMPANY PETROLEUM, INCORPORATED

SEC. 10 T. 29S R. 7W

FARM WRIGHT "F" NO. 1


LOC. C-SE, SW

TOTAL DEPTH 4590'

COUNTY KINGMAN CO., KANSAS

COMM. December 9, 1961 COMP. December 29, 1961

CONTRACTOR GARVEY DRILLING COMPANY

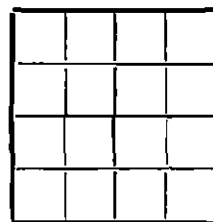

CASING 8-5/8" @ 360' w/250 sax.

ELEVATION 1617' DF

PRODUCTION D & A

FIGURES INDICATE BOTTOM OF FORMATIONS

130	Surface sand & shale
360	Red bed
1150	Shale & shells
1178	Anhydrite
1400	Shale, shells & lime
1660	Lime
2755	Shale & lime
3175	Lime & shale
3225	Shale & lime
3260	Lime & shale
3365	Shale
3862	Lime
3895	Shale
3944	Shale & lime
3980	Lime
4100	Shale & lime
4165	Lime & shale
4179	Shale
4230	Chert
4235	Lime & chert
4285	Lime
4350	Cherty lime & shale
4370	Lime
4410	Shale & lime
4457	Hard lime
4470	Lime & shale
4530	Shale
4565	Shale & lime
4574	Lime
4590	Sand
4590	T. D.

RECEIVED  
STATE OF KANSAS COMMISSION  
JAN 11 1962  
CONSERVATION DIVISION  
Wichita, Kansas

State of KANSAS }  
County of BARTON } ss

I, VERNE A. MORRIS of GARVEY DRILLING COMPANY

upon oath state the above and foregoing is a true and correct copy of the log of the #1 WRIGHT "F" well.

Verne A. Morris

Subscribed and sworn to before me this 18th day of January 1962

My Commission Expires: April 14, 1963

Arthur J. Wile  
NOTARY PUBLIC