


STATE OF KANSAS  
STATE CORPORATION COMMISSION  
CONSERVATION DIVISION  
P. O. BOX 17027  
WICHITA, KANSAS 67217

FORM CP-4

WELL PLUGGING RECORD

Kingman County, Sec. 10 Twp. 29S Rge. 7W (E) (W)

NORTH

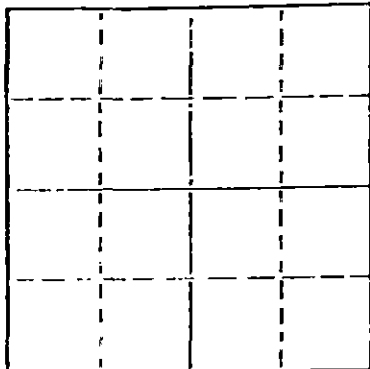

Locate well correctly on above Section Plat

Location as "NE/CNW/SE/SW" or footage from lines NE NE  
Lease Owner PICKRELL DRILLING COMPANY  
Lease Name Schrag M Well No. 1  
Office Address 705 4th National Bank Bldg. Wichita, Ks. 67202  
Character of Well (completed as Oil, Gas or Dry Hole) Dry Hole  
Date well completed 6-23-75 19  
Application for plugging filed 6-23-75 19  
Application for plugging approved 6-23-75 19  
Plugging commenced 6-23-75 19  
Plugging completed 6-23-75 19  
Reason for abandonment of well or producing formation Dry Hole

If a producing well is abandoned, date of last production \_\_\_\_\_ 19\_\_\_\_  
Was permission obtained from the Conservation Division or its agents before plugging was commenced? Yes

Name of Conservation Agent who supervised plugging of this well G. R. Biberstein  
Producing formation \_\_\_\_\_ Depth to top \_\_\_\_\_ Bottom \_\_\_\_\_ Total Depth of Well 4560 feet  
Show depth and thickness of all water, oil and gas formations.

OIL, GAS OR WATER RECORDS RECEIVED

CASING RECORD

FORMATION	STATE	CONTENT	FROM	TO	SIZE	PUT IN	PULLED OUT
					8 5/8	211	None

Describe in detail the manner in which the well was plugged, indicating where the mud fluid was placed and the method or methods used in introducing it into the hole. If cement or other plugs were used, state the character of same and depth placed, from \_\_\_\_\_ feet to \_\_\_\_\_ feet for each plug set.

25 sacks at 175'  
10 sacks at 40'  
Job completed at 3AM 6-23-75

(If additional description is necessary, use BACK of this sheet)

Name of Plugging Contractor PICKRELL DRILLING COMPANY  
Address 705 4th National Bk. Bldg. Wichita, Ks. 67202

STATE OF Kansas COUNTY OF Sedgwick ss.  
C. W. Sebitts

(employee of owner) or (owner or operator) of the above-described well, being first duly sworn on oath, says: That I have knowledge of the facts, statements, and matters herein contained and the log of the above-described well as filed and that the same are true and correct. So help me God.

(Signature) C. W. SEBITTS  
705 4th National Bk. Bldg. Wichita, Ks. 67202  
(Address)

SUBSCRIBED AND SWORN TO before me this 26 day of June, 19 75

My commission expires August 19, 1975

Helen L. Martin  
Helen L. Martin Notary Public.

15-095-20410-00-00  
ROTARY DRILLING LOG

COMPANY: PICKRELL DRILLING COMPANY  
705 4th National Bank Bldg.  
Wichita, Ks. 67202

Rotary Drilling Commenced 6-12-75

Rotary Drilling Completed 6-23-75

LOCATION: Schrag M #1  
NE NE 10-29S-7W  
Kingman County, Kansas

CONTRACTOR: **PICKRELL DRILLING COMPANY**  
Wichita, Kansas

CASING RECORD: 8 5/8" surface casing set at 211' cemented with 195 sacks. Date completed 6-12-75.

LOG

(Figures indicate bottom of formation — measurements from top of rotary bushing.)

TOP SOIL & Sand	105
Hard Sand & Red Bed	190
Shale	220
Shale	670
Shale & Shells	1195
Lime & Shale	1480
Lime-Rough	1535
Lime & Shale	1740
Lime & Shale	2025
Lime & Shale	2295
Lime & Shale	2520
Lime & Shale	2765
Lime & Shale	3040
Lime & Shale	3210
Lime & Shale	3375
Lime & Shale	3525
Lime & Shale	3630
Lime	3715
Lime	3810
Lime & Shale	3890
Lime & Shale	3970
Shale & Lime	4085
Shale & Lime	4119
Miss.	4134
Miss. & Shale	4250
Shale & Lime	4325
Lime & Shale	4410
Lime & Shale	4469
Shale	4508
Shale	4516
Shale & Sand	4560

RECEIVED  
STATE CORPORATIONS COMMISSION  
JUL 2 1975  
Wichita, Kansas

The undersigned, C. W. Sebifs, Attorney-in-Fact for PICKRELL DRILLING COMPANY, hereby certifies in behalf of said Company, that the above is a true and correct log of the formation encountered in drilling the above well as reflected by the Daily Drilling Reports.

PICKRELL DRILLING COMPANY

By *C. W. Sebifs*  
C. W. Sebifs Attorney-in-Fact

STATE OF KANSAS }  
COUNTY OF SEDGWICK } ss.:

On this 26 day of June, 19 75, before me the undersigned, a Notary Public, in and for

the County and State aforesaid, personally appeared C. W. Sebifs, to me known to be the identical person who subscribed the name of PICKRELL DRILLING COMPANY to the foregoing instrument as its Attorney-in-Fact and acknowledged to me that he executed the same as his free and voluntary act and deed, and as the free and voluntary act and deed of such company, for the uses and purposes therein set forth.

Given under my hand and seal of office the day and year last above written.

My commission expires: August 19, 1975

*Helen L. Martin*  
Notary Public  
Helen L. Martin