


WELL PLUGGING RECORD

Give All Information Completely
Make Required Affidavit
Mail or Deliver Report to:
Conservation Division
State Corporation Commission
800 Bitting Building
Wichita, Kansas

NORTH

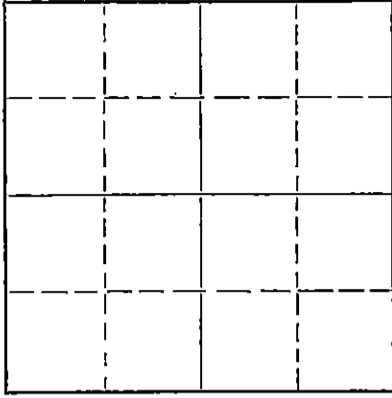

Locate well correctly on above
Section Plat

Kingman County. Sec. 11 Twp. 29S Rge. (E) 7 (W)
Location as "NE/CNW/SW" or footage from lines. SE SE SE
Lease Owner Beardmore Drilling Company
Lease Name Voran Well No. 1
Office Address 603 Petroleum Building, Wichita 2, Kansas
Character of Well (completed as Oil, Gas or Dry Hole) dry hole
Date well completed October 3, 19 53
Application for plugging filed October 3, 19 53
Application for plugging approved October 3, 19 53
Plugging commenced October 3, 19 53
Plugging completed October 3, 19 53
Reason for abandonment of well or producing formation dry hole

If a producing well is abandoned, date of last production _____ 19____
Was permission obtained from the Conservation Division or its agents before plugging was commenced? yes

Name of Conservation Agent who supervised plugging of this well Ruel Durkee
Producing formation _____ Depth to top _____ Bottom _____ Total Depth of Well 4720 Feet
Show depth and thickness of all water, oil and gas formations.

OIL, GAS OR WATER RECORDS

CASING RECORD

FORMATION	CONTENT	FROM	TO	SIZE	PUT IN	PULLED OUT
<u>Sand, red bed, shale</u>		<u>0</u>	<u>184</u>	<u>8-5/8</u>	<u>184</u>	<u>-0-</u>

Describe in detail the manner in which the well was plugged, indicating where the mud fluid was placed and the method or methods used in introducing it into the hole. If cement or other plugs were used, state the character of same and depth placed, from top feet to bottom feet for each plug set.

Heavy Mud from 180' to 4720'

Wood Plug @ 180'

15 Sacks Cements 130' to 180'

Heavy Mud from 35' to 130'

Wood Plug @ 35'

5 Sacks cement to surface.

RECEIVED
OCT 17 1953
CONSERVATION DIVISION
WICHITA, KANSAS

(If additional description is necessary, use BACK of this sheet)

Name of Plugging Contractor Beardmore Drilling Company
Address 603 Petroleum Building, Wichita 2, Kansas

STATE OF KANSAS, COUNTY OF SEDGWICK, ss.
I, HEBER BEARDMORE, (employee of owner) or (owner or operator) of the above-described

well, being first duly sworn on oath, says: That I have knowledge of the facts, statements, and matters herein contained and the log of the above-described well as filed and that the same are true and correct. So help me God.

(Signature) Heber Beardmore
603 Petroleum Building, Wichita 2, Kansas
(Address)

SUBSCRIBED AND SWORN to before me this 14th day of October, 19 53

Leonard P. Tolle
Notary Public.

My commission expires January 28, 1956

PLUGGING
FILE SEC. 11 T. 29. S. 7W
BOOK PAGE 133 LINE 35

VORAN NO. 1

SE SE SE
 Section 11-29S-7W $\frac{1}{2}$
 Kingman County, Kansas

Drilled for: Beardmore and O. A. Sutton
 Drilled by: Beardmore Drilling Company

Casing Record:

8-5/8" 184' w/110 Sacks

Drilling Commenced: September 16, 1953
 Drilling Completed: October 3, 1953

Elevation: DF 1609
 GR 1606

<u>FORMATION</u>	<u>DEPTH</u>
Cellar	5
Sand	150
Red Bed - Shale	186
Red Bed - Shale - Shells	1125
Lime Broken	1535
Lime - Shale	2200
Shale - Lime	2545
Lime - Shale	2690
Lime Broken	2855
Lime - Shale	3050
Shale - Lime	3375
Lime	3785
Lime - Shale	3840
Shale - Lime	3875
Lime - Shale	4015
Shale - Lime	4165
Lime	4170
Lime - Chert	4215
Lime	4420
Shale	4445
Shale - Lime	4515
Lime - Shale	4585
Sand - Shale	4610
Sand	4625
Sand - Shale - Chert	4660
Lime	4720 T. D.

D & A

TOPS:

Lansing
 Mississippi
 Viola
 Simpson
 Arbuckle

3353
 4145
 4557
 4577
 4677

RECEIVED
 STATE COMMISSION
 OCT 17 1953
 CONSERVATION DIVISION
 Wichita, Kansas

DST #1 - 3740-3750 - Open 1 hour, fair blow, shut in 15 minutes, recovered 185' muddy salt water, FP 130# SIP 1500#

DST # 2- 4147-4170 - Open 1 hour, shut in 15 minutes, fair blow throughout test, recovered 60' water, 250' mud, BHP 1050#.

STATE OF KANSAS

ss

COUNTY OF SEDGWICK

I, the undersigned, being duly sworn on oath state that the above and within statement is a true and correct record and log of the well drilled on the location above-described, to the best of my knowledge and belief.

Alb. Beardmore

Subscribed and sworn to before me this 14th day of October, 1953.

Leonard P. Tolle
 Notary Public

My Commission Expires:
 January 28, 1956

PLUGGING
 FW 11-29-7W
 ROCK PACK 133 LIFT 25