


WELL PLUGGING RECORD

Give All Information Completely  
Make Required Affidavit  
Mail or Deliver Report to:  
Conservation Division  
State Corporation Commission  
211 No. Broadway  
Wichita, Kansas

Kingman County. Sec. 30 Twp. 29 Rge. 6W (E) (W)

Location as "NE/CNW&SW&" or footage from lines NE NE NE

NORTH

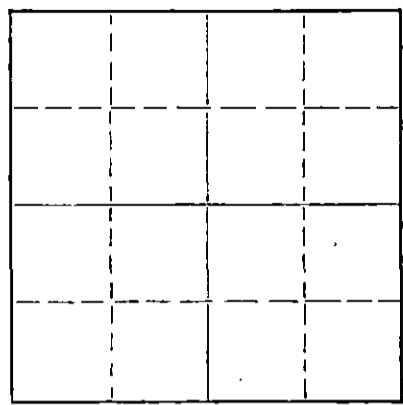

Locate well correctly on above Section Plat

Lease Owner M. B. Armer  
Lease Name Maple Well No. 1  
Office Address 710 Petroleum Building, Wichita, Kansas  
Character of Well (completed as Oil, Gas or Dry Hole) Dry Hole  
Date well completed July 8 1956  
Application for plugging filed July 8 1956  
Application for plugging approved July 8 1956  
Plugging commenced July 8 1956  
Plugging completed July 8 1956  
Reason for abandonment of well or producing formation oil in commercial quantities not found  
If a producing well is abandoned, date of last production 19  
Was permission obtained from the Conservation Division or its agents before plugging was commenced? yes

Name of Conservation Agent who supervised plugging of this well Ruel Durkee  
Producing formation \_\_\_\_\_ Depth to top \_\_\_\_\_ Bottom \_\_\_\_\_ Total Depth of Well 4686' Feet  
Show depth and thickness of all water, oil and gas formations.

OIL, GAS OR WATER RECORDS

CASING RECORD

FORMATION	CONTENT	FROM	TO	SIZE	PUT IN	PULLED OUT
				8-5/8"	236'	none

Describe in detail the manner in which the well was plugged, indicating where the mud fluid was placed and the method or methods used in introducing it into the hole. If cement or other plugs were used, state the character of same and depth placed, from \_\_\_\_\_ feet to \_\_\_\_\_ feet for each plug set.

Fill hole with extra heavy rotary mud from total depth to 235'. Set #1 Plug with 20 sacks cement, 1/4 sack Hulls. Filled hole with extra heavy rotary mud from Plug #1 to 35'. Set #2 Plug with 10 sacks cement, 1/2 sack Hulls.

07-14-56

(If additional description is necessary, use BACK of this sheet)

Name of Plugging Contractor Prime Drilling Company  
Address 1005 Central Building, Wichita, Kansas

STATE OF KANSAS, COUNTY OF Sedgwick, ss.  
L. J. Clampitt (employee of owner) or (owner or operator) of the above-described well, being first duly sworn on oath, says: That I have knowledge of the facts, statements, and matters herein contained and the log of the above-described well as filed and that the same are true and correct. So help me God. PRIME-DRILLING COMPANY

(Signature) [Signature]  
1005 Central Building, Wichita, Kansas  
(Address)

SUBSCRIBED AND SWORN TO before me this 13th day of July, 19 56

[Signature]

Notary Public.

My commission expires September 30, 1956

PLUGGING  
FILE SEC. 30 T. 29 R. 6W  
BOOK PAGE 77 LINE 45

ROTARY DRILLING LOG

OPERATOR: M. B. Armer  
 MAPLE NO. 1  
 NE NE NE Section 30-29-6W,  
 Kingman County, Kansas

CONTRACTOR: Prime Drilling Company  
 COMM: 6/15/56  
 COMP: 7/8/56

Remarks: Set 8-5/8" surface casing at  
 236' cemented with 185 sacks Pozmix,  
 2% C.C.

Formations:

Sand & Clay	90'
Sand	110'
Shale & Shell	236'
Red Bed & Shale	390'
Shale & Shells	1140'
Anhydrite	1180'
Anhydrite & Gyp	1340'
Lime & Shale	1620'
Sandy Lime & Shale	1730'
Lime & Shale	2560'
Lime & Shale Streaks	2750'
Lime & Shale	2850'
Lime	3175'
Lime & Shale	3245'
Lime	3535'
Lime & Shale	3610'
Lime	3815'
Lime & Shale	3860'
Lime	3995'
Lime & Shale	4165'
Lime	4240'
Lime w/ Chert Streaks	4305'
Lime	4323'
Lime & Chert	4340'
Lime	4470'
Lime & Shale	4525'
Lime	4536'
Sand & Lime	4557'
Sand & Shale	4590'
Shale & Lime	4597'
Shale w/ Lime Streaks	4610'
Sandy Lime	4642'
Lime w/ Shale Streaks	4669'
Arbuckle	4686'
Rotary Total Depth (D&A)	4686'

We certify the above log is true and  
 correct to the best of our knowledge  
 and belief.

PRIME DRILLING COMPANY

*R. R. McNicol*

R. R. McNicol

PLUGGING  
 FILE SEC. 30 T. 29 R. 6W  
 BOOK PAGE 77 LINE 45