


STATE OF KANSAS  
STATE CORPORATION COMMISSION

15-095-00933-0000  
Form CP-4

Give All Information Completely  
Make Required Affidavit  
Mail or Deliver Report to:  
Conservation Division  
State Corporation Commission  
P. O. Box 17027  
Wichita, Kansas 67217  
NORTH

WELL PLUGGING RECORD

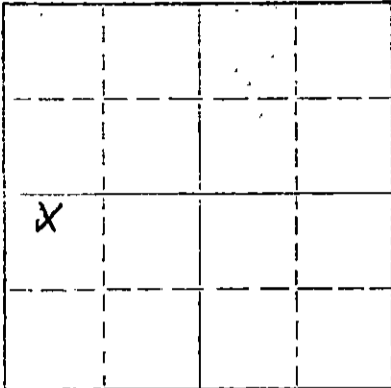

Locate well correctly on above Section Plat

Kingman County, Sec 30 Twp. 29 Rge. 6 (E) W (W)  
Location as "NE/CNW/SW" or footage from lines N/2 NW SW  
Lease Owner Pickrell Drlg. Co. ; Wichita, Kans. 67202  
Lease Name Maple I Well No. #2  
Office Address 705 Fourth National Bank Building  
Character of Well (completed as Oil, Gas or Dry Hole) Oil  
Date well completed Feb. 20 1963  
Application for plugging filed October 27 19 72  
Application for plugging approved October 28 19 72  
Plugging commenced November 16 19 72  
Plugging completed November 25 19 72  
Reason for abandonment of well or producing formation Well Depleted

If a producing well is abandoned, date of last production Oct. 24 19 72  
Was permission obtained from the Conservation Division or its agents before plugging was commenced? Yes

Name of Conservation Agent who supervised plugging of this well Russell Biberstein  
Producing formation Mississippian Depth to top 4122 Bottom 4163 Total Depth of Well 4163 Feet  
Show depth and thickness of all water, oil and gas formations.

OIL, GAS OR WATER RECORDS

CASING RECORD

FORMATION	CONTENT	FROM	TO	SIZE	PUT IN	PULLED OUT
				8 5/8"	221	None
				5 1/2"	4130	3372

Describe in detail the manner in which the well was plugged, indicating where the mud fluid was placed and the method or methods used in introducing it into the hole. If cement or other plugs were used, state the character of same and depth placed, from \_\_\_\_\_ feet to \_\_\_\_\_ feet for each plug set.

November 16, 1972 Plugged off bottom. Dumped sand to 4150'.  
Mixed and dumped 5 sx of cement.

November 25, 1972 Plugged off top. Set 10' rock bridge at  
320'. Filled 8 5/8" surface casing from  
320' to base of cellar with 3000 lb. ready-  
mix concrete.

RECEIVED  
STATE CORPORATION COMMISSION  
DEC 7 - 1972  
CONSERVATION DIVISION  
Wichita, Kansas

(If additional description is necessary, use BACK of this sheet)


Name of Plugging Contractor RUSS CASING PULLING, INC.  
Address P. O. Box 1082 ; Great Bend, Kansas 67530

STATE OF Kansas COUNTY OF Sedgwick ss.  
Dale M. Robinson (employee of owner) or (owner or operator) of the above-described

well being first duly sworn on oath, says: That I have knowledge of the facts, statements, and matters herein contained and the log of the above described well as filed and that the same are true and correct. So help me God.

(Signature) Dale M. Robinson  
705 Fourth National Bank Bldg., Wichita, Kansas  
(Address)

Subscribed and sworn to before me this 6th day of December, 1972

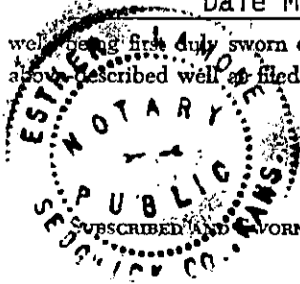

Esther Lamone  
Notary Public.

January 19, 1973

My commission expires \_\_\_\_\_

ROTARY DRILLING LOG

*File Copy*

COMPANY: Pickrell Drilling Company  
705 4th National Bank Building  
Wichita, Kansas  
LOCATION: Maple "I" No. 2  
C N NW SW 30-29S-6W, Kingman County, Kansas

Rotary Drilling Commenced 1-24-63

Rotary Drilling Completed 2-3--63

CONTRACTOR: **PICKRELL DRILLING COMPANY**  
Wichita, Kansas

CASING RECORD: 221' (6 jts.) 8 5/8" surface casing set with 175 sacks cement.  
Circulated. (129 jts) 5 1/2" casing set at 4130.50' with 90  
sacks cement. Completed at 5:30 A.M. 2-4-63.

LOG

(Figures indicate bottom of formation — measurements from top of rotary bushing.)

40	Sand	<u>C. F. S.</u>
221	Red Rock	4100
810	Red Rock & Shale	4110
1250	Shale & Shells	4120
1500	Lime & Shale	4131
1650	Lime	
2105	Lime & Shale	<u>Slope Test</u>
2290	Shale	1500
3250	Lime & Shale	2100
3753	Lime	2900
4090	Lime & Shale	3700
4131	Mississippian - RTD	
		<u>S. L. M.</u>
		299
		3581
		3753

RECEIVED  
STATE CORPORATION COMMISSION  
OCT 30 1972  
CONSERVATION DIVISION  
Wichita, Kansas

The undersigned, C. W. SEBITS, Attorney-in-Fact for PICKRELL DRILLING COMPANY, hereby certifies in behalf of said Company, that the above is a true and correct log of the formation encountered in drilling the above well as reflected by the Daily Drilling Reports.

PICKRELL DRILLING COMPANY  
By *C. W. Sebits*  
C. W. SEBITS Attorney-in-Fact

STATE OF KANSAS }  
COUNTY OF SEDGWICK } ss.:

On this 7th day of February, 1963, before me the undersigned, a Notary Public, in and for the County and State aforesaid, personally appeared C. W. SEBITS, to me known to be the identical person who subscribed the name of PICKRELL DRILLING COMPANY to the foregoing instrument as its Attorney-in-Fact and acknowledged to me that he executed the same as his free and voluntary act and deed, and as the free and voluntary act and deed of such company, for the uses and purposes therein set forth.

Given under my hand and seal of office the day and year last above written.

My commission expires: June 21, 1966

*Maxine Blackman*  
Maxine Blackman Notary Public