


WELL PLUGGING RECORD

Well Information Completely
Make Required Affidavit
Mail or Deliver Report to:
Conservation Division
State Corporation Commission
211 No. Broadway
Wichita, Kansas

NORTH

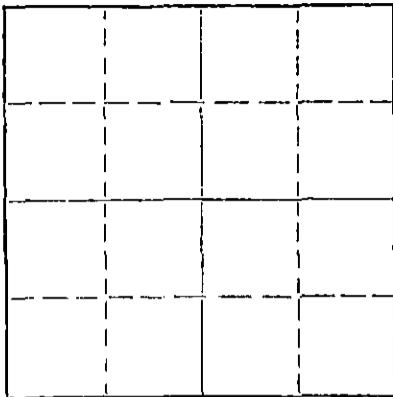

Locate well correctly on above
Section Plat

Kingman County, Sec. 30 Twp. 29S Rge. (E) 6 (W)
Location as "NE/CNW/SW" or footage from lines C NE SW
Lease Owner Pickrell Drilling Company
Lease Name Maple I Well No. 1
Office Address 705 4th Natl Bk Bldg, Wichita 2, Kansas
Character of Well (completed as Oil, Gas or Dry Hole) Dry Hole
Date well completed August 17 19 62
Application for plugging filed August 17 19 62
Application for plugging approved August 17 19 62
Plugging commenced August 17 19 62
Plugging completed August 17 19 62
Reason for abandonment of well or producing formation Dry Hole

If a producing well is abandoned, date of last production 19
Was permission obtained from the Conservation Division or its agents before plugging was commenced? Yes

Name of Conservation Agent who supervised plugging of this well Fred Hampel
Producing formation _____ Depth to top _____ Bottom _____ Total Depth of Well 4200 Feet
Show depth and thickness of all water, oil and gas formations.

OIL, GAS OR WATER RECORDS

CASING RECORD

FORMATION	CONTENT	FROM	TO	SIZE	PUT IN	PULLED OUT
				8 5/8"	228'	None

Describe in detail the manner in which the well was plugged, indicating where the mud fluid was placed and the method or methods used in introducing it into the hole. If cement or other plugs were used, state the character of same and depth placed, from _____ feet to _____ feet for each plug set.

Heavy mud to 180'. Set Plug. Cemented with
20 sacks cement. Heavy mud to 35'. Set plug.
Cemented with 10 sacks to bottom of cellar.
Plugged rat hole with 2 sacks cement.

RECEIVED
STATE CORPORATION COMMISSION

SEP 10 1962 09-10-62

CONSERVATION DIVISION
Wichita, Kansas

(If additional description is necessary, use BACK of this sheet)

Name of Plugging Contractor Pickrell Drilling Company
Address 705 Fourth National Bank Building, Wichita 2, Kansas

STATE OF KANSAS, COUNTY OF _____, ss.
C. W. SEBITS

(owner or operator) of the above-described well, being first duly sworn on oath, says: That I have knowledge of the facts, statements, and matters herein contained and the log of the above-described well as filed and that the same are true and correct. So help me God.

(Signature) C. W. Sebits
705 4th Natl Bk Bldg, Wichita 2, Kansas
(Address)

SUBSCRIBED AND SWORN TO before me this 4th day of September, 1962

Maxine Blackman
Notary Public.

My commission expires June 21, 1966



ROTARY DRILLING LOG

COMPANY: Pickrell Drilling Company
705 Fourth National Bank Bldg.
Wichita 2, Kansas
LOCATION: Maple "I" #1 C NE SW

Rotary Drilling Commenced 8-7-62
Rotary Drilling Completed 8-17-62

CONTRACTOR: **PICKRELL DRILLING COMPANY**
Wichita, Kansas

Sec: 30-29S-6W, Kingman County, Kansas

CASING RECORD: (8 jts) 8 5/8" Surface Casing set at 228', cemented with 165 sacks cement. Circulated. Completed 6:30 P.M. 8-7-62. No oil string run. D & A.

LOG

(Figures indicate bottom of formation — measurements from top of rotary bushing.)

15	Sand		Circulated for samples
110	Red Rock	4114'	4135'
229	Red rock & blue shale	4122'	4140'
740	Shale & shells	4128'	4152'
1185	Shale, shells & lime	4134'	4162'
1375	Lime & shale		4200'
3362	Lime		
3902	Lime & shale		<u>Slope Test</u>
4134	Mississippian		
4200	Miss. Lime R.T.D.		2500'
			3000'
			3500'
			4000'
			<u>S. I. M.</u>
			2595'
			3490'
			3902'

RECEIVED
STATE CORPORATION COMMISSION

SEP 10 1962

CONSERVATION DIVISION
Wichita, Kansas

The undersigned, C. W. Sebitts, Attorney-in-Fact for PICKRELL DRILLING COMPANY, hereby certifies in behalf of said Company, that the above is a true and correct log of the formation encountered in drilling the above well as reflected by the Daily Drilling Reports.

PICKRELL DRILLING COMPANY

By C.W. Sebitts
C.W. Sebitts Attorney-in-Fact

STATE OF KANSAS }
COUNTY OF SEDGWICK } ss.:

On this 4th day of September, 1962, before me the undersigned, a Notary Public, in and for the County and State aforesaid, personally appeared C. W. SEBITS, to me known to be the identical person who subscribed the name of PICKRELL DRILLING COMPANY to the foregoing instrument as its Attorney-in-Fact and acknowledged to me that he executed the same as his free and voluntary act and deed, and as the free and voluntary act and deed of such company, for the uses and purposes therein set forth.

Given under my hand and seal of office the day and year last above written.

My commission expires: June 21, 1966

Maxine Blackman
Maxine Blackman Notary Public