


WELL PLUGGING RECORD

15-095-01504-0000

All Information Completely
The Required Affidavit
File or Deliver Report to:
Conservation Division
State Corporation Commission
211 No. Broadway
Wichita, Kansas

Kingman County, Sec. 33 Twp 29S. Rge. 6W (X) (W)

Location as "NE/CNW/SW" or footage from lines SE/4
 Location as "NE/CNW/SW" or footage from lines SE/4
 Owner Texaco, Incorporated
 Name Pieplow-Campbell Well No. 1
 Address 614 Bitting Building, Wichita, Kansas
 Character of Well (completed as Oil, Gas or Dry Hole) Dry Hole
 Date well completed 3-26-63 19
 Application for plugging filed 3-26-63 19
 Application for plugging approved 3-26-63 19
 Plugging commenced 3-26-63 19
 Plugging completed 3-26-63 19
 Reason for abandonment of well or producing formation Dry Hole

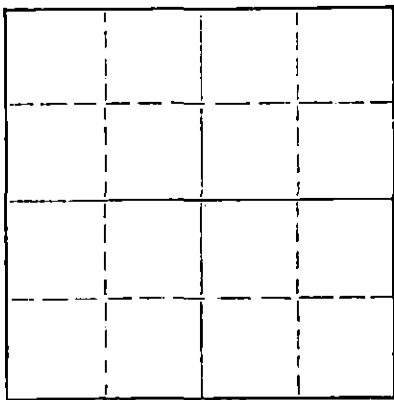

Locate well correctly on above Section Plat

If producing well is abandoned, date of last production 19
 Was permission obtained from the Conservation Division or its agents before plugging was commenced? yes

Name of Conservation Agent who supervised plugging of this well Archie Elving, Pratt, Kansas
 Producing formation _____ Depth to top _____ Bottom _____ Total Depth of Well 3756 Feet
 Show depth and thickness of all water, oil and gas formations.

OIL, GAS OR WATER RECORDS

CASING RECORD

FORMATION	DEPTH	FROM	TO	SIZE	PUT IN	PULLED OUT
				8 5/8"	217'	none

Describe in detail the manner in which the well was plugged, indicating where the mud fluid was placed and the method or methods used in introducing it into the hole. If cement or other plugs were used, state the character of same and depth placed, from _____ feet to _____ feet for each plug set.

RECEIVED
STATE CORPORATION COMMISSION

MAR 29 1963

1st plug @ 180' with 1/2 sk. hulls and 20 sks. cement

Mud to 40' & 2nd plug @ 40' with 10 sks. cement

CONSERVATION DIVISION
Wichita, Kansas

(If additional description is necessary, use BACK of this sheet)

Name of Plugging Contractor Leben Drilling, Inc.
 Address P. O. Box 486, Great Bend, Kansas

STATE OF KANSAS, COUNTY OF BARTON, ss.
 Leben Drilling, Inc. (employee of owner) or (owner or operator) of the above-described

well, being first duly sworn on oath, says: That I have knowledge of the facts, statements, and matters herein contained and the log of the above-described well as filed and that the same are true and correct. So help me God.

(Signature) Leslie Kite
 P. O. Box 486, Great Bend, Kansas
 (Address)

SUBSCRIBED AND SWORN TO before me this 28th day of March, 19 63

My commission expires April 1, 1963

Ulanda Nichols
 Notary Public.

INVOICED

DATE 3/29/63

INV. NO. 6794-4

DRILLER'S LOG

COMPANY: Texaco, Incorporated
 CONTRACTOR: LEBEN DRILLING, INC.
 FARM: PIEPLOW-CAMPBELL #1
 LOCATION: C NE/4 of SE/4 Sec. 33-29S-6W
 KINGMAN COUNTY, KANSAS
 COMMENCED: 3-16-63
 COMPLETED: 3-26-63

15-095-01504-0000

0	20	Sand
20	60	Redbed & Shale
60	170	Shale
170	600	Shale & Redbed
600	800	Shale & Lime
800	975	Red Rock & Lime
975	1010	Anhydrite
1010	1290	Shale & Lime
1290	3044	Lime & Shale
3044	3315	Lime
3315	3483	Shale & Lime
3483	3756	Lime
	<u>3756</u>	<u>Rotary Total Depth - D. & A.</u>

RECEIVED
 STATE CORPORATION COMMISSION
 MAR 29 1963
 CONSERVATION DIVISION
 Wichita, Kansas

Set 8 5/8" used surface casing @ 217' Cemented with 200 sacks Posmix, 2% c.c.

I, Leslie Kite, do hereby certify that the above and foregoing is a true and correct copy of the log of the Pieplow-Campbell #1, located SE Quarter of Section 33, Township 29 South, Range 6 West, Kingman County, Kansas, as reflected by the files of Leben Drilling, Inc.

Leslie Kite
 Leslie Kite

STATE OF KANSAS)
) SS
 COUNTY OF BARTON)

Subscribed and sworn to before me, a Notary Public, in and for Barton County, Kansas, this 28th day of March, 1963.

Ulanda Nichols
 Ulanda Nichols, Notary Public

My Commission Expires:
 April 1, 1963