

STATE OF KANSAS
STATE CORPORATION COMMISSION


Give All Information Completely
Make Required Affidavit
Mail or Deliver Report to:
Conservation Division
State Corporation Commission
211 No. Broadway
Wichita, Kansas

15-095-00262-0000
WELL PLUGGING RECORD

Kingman County, Sec. 36 Twp. 29S Rge. (E) 6 (W)

Location as "NE/CNW%SW%" or footage from lines NE/4 NE/4 SE/4
Lease Owner Walters Drilling Co., et al
Lease Name Graber Well No. 1
Office Address 510 Orpheum Building, Wichita 2, Kansas
Character of Well (completed as Oil, Gas or Dry Hole) Dry Hole
Date well completed October 13, 1957
Application for plugging filed (verbal) October 13, 1957
Application for plugging approved (verbal) October 13, 1957
Plugging commenced October 13, 1957
Plugging completed October 13, 1957
Reason for abandonment of well or producing formation Dry Hole

6W

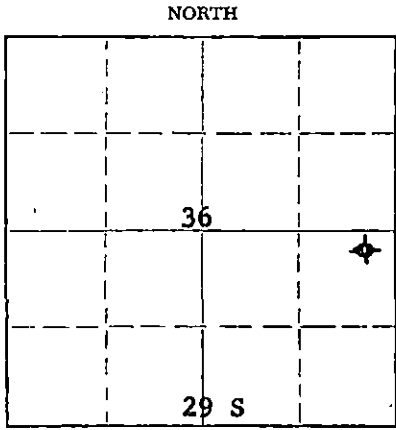

Locate well correctly on above
Section Plat

If a producing well is abandoned, date of last production _____ 19____
Was permission obtained from the Conservation Division or its agents before plugging was commenced? Yes

Name of Conservation Agent who supervised plugging of this well M. A. Rives
Producing formation None Depth to top _____ Bottom _____ Total Depth of Well 4505 Feet
Show depth and thickness of all water, oil and gas formations.

OIL, GAS OR WATER RECORDS

CASING RECORD

FORMATION	CONTENT	FROM	TO	SIZE	PUT IN	PULLED OUT
None	None	0	254'	8 5/8"	254'	None
	No oil string - D & A					

Describe in detail the manner in which the well was plugged, indicating where the mud fluid was placed and the method or methods used in introducing it into the hole. If cement or other plugs were used, state the character of same and depth placed, from _____ feet to _____ feet for each plug set.

Filled hole with heavy mud to 250', set bottom plug at 250' with 20 sacks cement.
Filled hole with heavy mud to 35', set top plug at 35' with 10 sacks cement.

(If additional description is necessary, use BACK of this sheet)

Name of Plugging Contractor Walters Drilling Co.
Address 510 Orpheum Building, Wichita 2, Kansas

STATE OF Kansas, COUNTY OF Sedgwick, ss.
Robert F. Walters (owner or operator) of the above-described well, being first duly sworn on oath, says: That I have knowledge of the facts, statements, and matters herein contained and the log of the above-described well as filed and that the same are true and correct. So help me God.

(Signature) Robert F. Walters
510 Orpheum Building, Wichita 2, Kansas
(Address)

SUBSCRIBED AND SWORN TO before me this 16th day of October, 19 57
Pauline Rudickson
Notary Public.

My commission expires March 10, 1960

PLUGGING
FILE SEC 36 T 29 R 6W
BOOK PAGE 53 LINE 31

OCT 1
CONSERVATION DIVISION
Wichita, Kansas

RCWD
10-19-57

GRABER NO. 1

Location: NE/4 NE/4 SE/4 Sec. 36-29S-6W Date Spudded: 9-28-57
Kingman County, Kansas
Operator: Walters Drilling Co. Completion: 10-13-57
Contractor: Walters Drilling Co. Elevation: 1507 Gr
1509 DF
1512 KB
Surface Casing: 8 5/8" set at 254.75' with
150 sacks cement and
3 Cal. Chloride
Oil String: None. D & A

L O G

(Figures indicate bottom of formation)

Surface	0 to 254
Red Bed and Shale	760
Shale	1000
Shale and Salt	1130
Shale and Shells	1283
Shale and Lime	3617
Lime	3666
Lime and Chert	3709
Lime	3740
Lime and Shale	4416
Shale	4467
Lime and Chert	4503
Lime	4505
Total Depth	4505

The undersigned, Robert F. Walters, hereby certifies that the above log is a true and correct log of the formations encountered in drilling the above noted well as reflected by the Daily Drilling Reports.

WALTERS DRILLING CO.


By

Robert F. Walters

Subscribed and sworn to before me
this 16th day of October, 1957

Pauline Rudnickson
Notary Public

My commission expires:
March 10, 1960

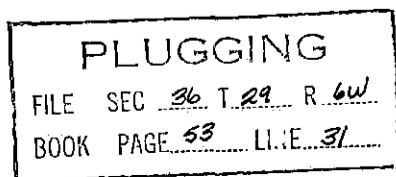

RECORDED
STATE CORP.
OCT 19 1957
CONSERVATION DIVISION
Wichita, Kansas