


STATE OF KANSAS
STATE CORPORATION COMMISSION

WELL PLUGGING RECORD

15-095-20569-0000

Give All Information Completely
Make Required Affidavit
Mail or Deliver Report to
Conservation Division
State Corporation Comm.
245 North Water
Wichita, KS 67202

Kingman County. Sec. 15 Twp. 29S Rge. 8 E/W
Location as "NE/CNW 1/4 SW 1/4" or footage from lines _____
1980' ESL & 660' FWL
Lease Owner TEXAS OIL & GAS CORP.
Lease Name VORAN Well No. 1
Office Address 200 W. Douglas, Suite 300, Wichita KS 67202
Character of Well (Completed as Oil, Gas or Dry Hole) _____
Dry Hole
Date Well completed 4-23-77 19____
Application for plugging filed 4-23-77 19____
Application for plugging approved 4-23-77 19____
Plugging commenced 4-23-77 19____
Plugging completed 4-23-77 19____
Reason for abandonment of well or producing formation _____

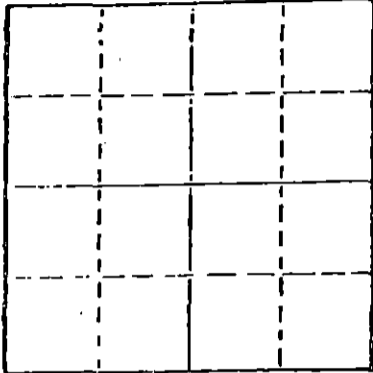

Locate well correctly on above
Section Plot

If a producing well is abandoned, date of last production _____ 19____

Was permission obtained from the Conservation Division or
its agents before plugging was commenced? Yes

Name of Conservation Agent who supervised plugging of this well J. H. Metz
Producing formation _____ Depth to top _____ Bottom _____ Total Depth of Well _____
Show depth and thickness of all water, oil and gas formations.

OIL, GAS OR WATER RECORDS

CASING RECORD

FORMATION	CONTENT	FROM	TO	SIZE	PUT IN	PULLED OUT
		0	252'	8 5/8"	6 jts.	

Describe in detail the manner in which the well was plugged, indicating where the mud fluid
was placed and the method or methods used in introducing it into the hold. If cement or other
plugs were used, state the character of same and depth placed, from _____ feet to
_____ feet for each plug set.

Heavy mud from TD to 240' 35 sack cement plug
mud to 40' 1/2 sacks hulls, cement plug, 15 sacks
to base of cellar, 5 sacks rat hole.

RECEIVED
STATE CORPORATION COMMISSION

MAY 04 1977 05-04-77

CONSERVATION DIVISION
Wichita, Kansas

(If additional description is necessary, use BACK of this sheet)

Name of Plugging Contractor Xplor Drilling Co.

STATE OF KANSAS COUNTY OF SEDGWICK, ss.
Wayne L. Kirkman (~~employee~~ owner) or (owner or operator)
of the above-described well, being first duly sworn on oath, says: That I have knowledge of
the facts, statements, and matters herein contained and the log of the above-described well
as filed and that the same are true and correct. So help me God.

(Signature) Wayne L. Kirkman
180 S. Rock Road, Suite 300, Wichita KS 67207
(Address)

SUBSCRIBED AND SWORN TO before me this 25 day of April, 19 77

Virginia Lee Smith
Virginia Lee Smith Notary Public.

My commission expires August 25, 1980

