

STATE CORPORATION COMMISSION OF KANSAS
OIL & GAS CONSERVATION DIVISION
WELL COMPLETION OR RECOMPLETION FORM
ACO-1 WELL HISTORY
DESCRIPTION OF WELL AND LEASE

5

API NO. 15-...069-20,230-0000

County...Gray

C...NE.SW ... ~~Sec 8~~ Twp 24 S Rge. 29W. East West

1980
3300
Ft North from Southeast Corner of Section
Ft West from Southeast Corner of Section
(Note: Locate well in section plat below)


Lease Name...Markel...Well #...1...

Field Name...WC

Producing Formation...N/A

Elevation: Ground. 2788...KB... 2793...

Section Plat

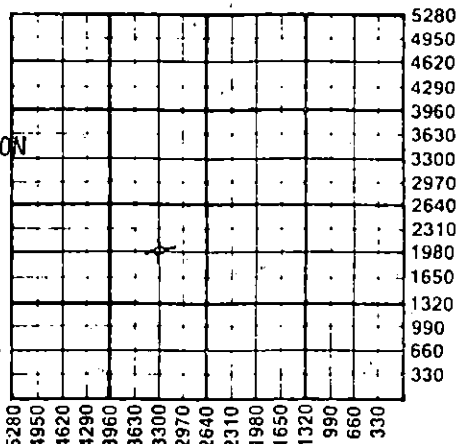

WATER SUPPLY INFORMATION

Disposition of Produced Water: Disposal
Docket # Repressuring

Questions on this portion of the ACO-1 call:

Water Resources Board (913) 296-3717

Source of Water:
Division of Water Resources Permit #...88-271.....

Groundwater. 2000..Ft North from Southeast Corner
(Well) ..3100Ft West from Southeast Corner of
Sec 8 Twp 24 Rge 29W ~~XXXXX~~ West

Surface Water.....Ft North from Southeast Corner
(Stream, pond etc).....Ft West from Southeast Corner
Sec Twp Rge East West

Other (explain).....
(purchased from city, R.W.D. #)

Operator: License # 5140
Name ..Frontier Oil Company
Address 125 N. Market, Ste. 1720
City/State/Zip ..Wichita, Kansas.. 67202.

Purchaser.....N/A

Operator Contact PersonGeorgia A. Angle
Phone ..316-263-1201

Contractor: License # ..5302
Name ..Red Tiger Drilling Co.

Wellsite Geologist. Richard D. Parker
Phone...913-483-5348

Designate Type of Completion
 New Well Re-Entry Workover

Oil SWD Temp Abd
 Gas Inj Delayed Comp.
 Dry Other (Core, Water Supply etc.)

If ~~OWD~~ old well info as follows:
Operator
Well Name
Comp. DateOld Total Depth.....

WELL HISTORY

Drilling Method:
 Mud Rotary Air Rotary Cable
6-20-88 6-30-88 7-1-88
Spud Date Date Reached TD Completion Date
4845 N/A
Total Depth PBTD

Amount of Surface Pipe Set and Cemented at.....feet
Multiple Stage Cementing Collar Used? Yes No
If yes, show depth set.....feet
If alternate 2 completion, cement circulated
from.....feet depth to.....w/.....SX cmt
Cement Company Name
Invoice #

Alt II Dra

RECEIVED
7-22-88
JUL 22 1988
STATE CORPORATION COMMISSION
CONSERVATION DIVISION
Wichita, Kansas

INSTRUCTIONS: This form shall be completed in triplicate and filed with the Kansas Corporation Commission, 200 Colorado Derby Building, Wichita, Kansas 67202, within 120 days of the spud date of any well. Rule 82-3-130, 82-3-107 and 82-3-106 apply. Information on side two of this form will be held confidential for a period of 12 months if requested in writing and submitted with the form. See rule 82-3-107 for confidentiality in excess of 12 months. One copy of all wireline logs and drillers time log shall be attached with this form. Submit CP-4 form with all plugged wells. Submit CP-111 form with all temporarily abandoned wells.

All requirements of the statutes, rules and regulations promulgated to regulate the oil and gas industry have been fully complied with and the statements herein are complete and correct to the best of my knowledge.

Signature *Jon Angle*
Title.....Agent..... Date 7-20-88

Subscribed and sworn to before me this 20th day of July 1988
Notary Public *Anna Drennan*
Date Commission Expires 2-10-90

K.C.C. OFFICE USE ONLY
 Letter of Confidentiality Attached
 Wireline Log Received
 Drillers Time Log Received
Distribution
 KCC SWD/Rep NGPA
 KGS Plug Other
(Specify)
7-20-88

Sec. 8 Twp 24 Rge 29W