

STATE OF KANSAS
STATE CORPORATION COMMISSION


WELL PLUGGING RECORD

15-095-20904-000

Give All Information Completely
Make Required Affidavit
Mail or Deliver Report to
Conservation Division
State Corporation Comm.
245 North Water
Wichita, KS 67202

Kingman County, Sec. 31 Twp. 29 Rge. 5 E/W
Location as "NE/CNW $\frac{1}{2}$ SW $\frac{1}{2}$ " or footage from lines
NW SE NW

Lease Owner Texas Oil & Gas Corp.
Lease Name Stucky 'A' Well No. 1
Office Address 200 West Douglas, Wichita, Kansas 67202
Character of Well (Completed as Oil, Gas or Dry Hole)
Dry Hole

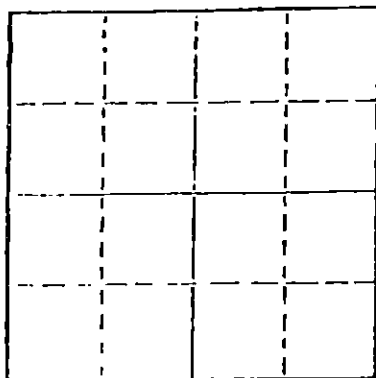

Locate well correctly on above Section Plat

Date Well completed 12/19/79 19
Application for plugging filed 12/19/79 19
Application for plugging approved 12/19/79 19
Plugging commenced 12/19/79 19
Plugging completed 12/19/79 19
Reason for abandonment of well or producing formation

If a producing well is abandoned, date of last production 19

Was permission obtained from the Conservation Division or its agents before plugging was commenced? yes

Name of Conservation Agent who supervised plugging of this well Wm. T. Owen
Producing formation Depth to top Bottom Total Depth of Well
Show depth and thickness of all water, oil and gas formations. ID 4590'

OIL, GAS OR WATER RECORDS

CASING RECORD

FORMATION	CONTENT	FROM	TO	SIZE	PUT IN	PULLED OUT
	Surface	0	262	8-5/8"	yes	no

Describe in detail the manner in which the well was plugged, indicating where the mud fluid was placed and the method or methods used in introducing it into the hold. If cement or other plugs were used, state the character of same and depth placed, from feet to feet for each plug set.

1st plug @ 270' with 40 sacks
2nd plug @ 40' with 10 sacks
5 sacks in rathole
Job complete @ 3:15 a.m. 12/19/79

RECEIVED
STATE CORPORATION COMMISSION

JAN - 7 1980 01-07-80

CONSERVATION DIVISION
Wichita, Kansas

(If additional description is necessary, use BACK of this sheet)

Name of Plugging Contractor Slawson Drilling Company, Inc.

STATE OF Kansas COUNTY OF Sedgwick, ss.
James C. Remsberg of Slawson Drilling Co., Inc. (employee of owner) or (owner or operator) of the above-described well, being first duly sworn on oath, says: That I have knowledge of the facts, statements, and matters herein contained and the log of the above-described well as filed and that the same are true and correct. So help me God.

(Signature) James C. Remsberg
James C. Remsberg
200 Douglas Building, Wichita, Ks. 67202
(Address)

SUBSCRIBED AND SWORN TO before me this 2 day of January, 19 80

Mary Lou Taylor
Mary Lou Taylor Notary Public.

My commission expires January 17, 1981

DRILLERS LOG

15-095-20904-0000

OPERATOR: Texas Oil & Gas Corp.
 200 West Douglas Street
 Wichita, Kansas 67202

LEASE NAME: Stucky 'A' #1
 ? ~~NW SE~~ NW Sec. 31-29S-5W
 Kingman County, Kansas

CONTRACTOR: Slawson Drilling Company, Inc.
 200 Douglas Building
 Wichita, Kansas 67202

COMMENCED: 12/5/79

COMPLETED: 12/19/79

RTD: 4590'

SURFACE CASING: 8-5/8" set at 262' with 250 sx cement

0' to 70' Sand
 70' to 115' Rock
 115' to 265' Rock & Sand
 265' Shale
 265' to 695' Red Bed-Shale
 695' to 1110' Sand & Rock
 1110' to 1355' Shale
 1355' to 1482' Lime & Shale
 1482' to 2043' Shale
 2043' to 2280' Shale & Sand
 2280' to 2395' Shale
 2395' to 2540' Lime & Shale
 2540' to 2820' Shale
 2820' to 2975' Shale & Lime
 2975' to 3110' Shale
 3110' to 3345' Shale & Lime
 3345' to 3770' Lime & Shale
 3770' to 3875' Shale & Lime
 3875' to 3970' Lime
 3970' to 4060' Lime & Shale
 4060' to 4090' Shale & Lime
 4090' to 4475' Lime
 4475' to 4491' Shale & Lime
 4491' to 4499' Lime
 4499' to 4555' Lime
 4555' to 4590' Sandstone & Shale
 RTD 4590'

RECEIVED
 STATE CONSERVATION COMMISSION
 JAN - 7 1980
 CONSERVATION DIVISION
 Wichita, Kansas

STATE OF KANSAS
 COUNTY OF Sedgwick

I, James C. Rensberg, of the Slawson Drilling Company, Inc. hereby state the above is an accurate copy of the Stucky 'A' log for Texas Oil & Gas Corp.

James C. Rensberg
 James C. Rensberg

Subscribed and sworn to me this
 3rd day of January, 1980

Mary Lou Taylor
 Mary Lou Taylor, Notary

My Commission expires January 17, 1981

