


STATE OF KANSAS
STATE CORPORATION COMMISSION

Give All Information Completely
Make Required Affidavit
Mail or Deliver Report to:
Conservation Division
State Corporation Commission
212 No. Market
Wichita, Kansas

WELL PLUGGING RECORD

Location as "NE/CNW/SW" or footage from lines Kingman County, Sec. 31 Twp. 29 Rge. 5 (E) (WX) NE SW NW
 Lease Owner E. K. Edmiston
 Lease Name Ewing Well No. #1
 Office Address 425 National Bank Bldg. Wichita, Kansas
 Character of Well (completed as Oil, Gas or Dry Hole) _____
 Date well completed _____ 19____
 Application for plugging filed _____ 19____
 Application for plugging approved _____ 19____
 Plugging commenced 2-9-70 _____ 19____
 Plugging completed 2-11-70 _____ 19____
 Reason for abandonment of well or producing formation _____
 If a producing well is abandoned, date of last production _____ 19____
 Was permission obtained from the Conservation Division or its agents before plugging was commenced? _____

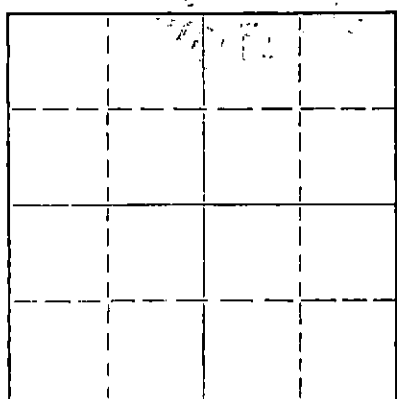

Locate well correctly on above Section Plat

Name of Conservation Agent who supervised plugging of this well G. R. Biberstein
 Producing formation _____ Depth to top _____ Bottom _____ Total Depth of Well 4484' Feet
 Show depth and thickness of all water, oil and gas formations.

OIL, GAS OR WATER RECORDS				CASING RECORD		
FORMATION	CONTENT	FROM	TO	SIZE	PUT IN	PULLED OUT
				4 1/2"	4475'	4070.78'
				8 5/8"	290'	
RECEIVED STATE CORPORATION COMMISSION FEB 13 1970 CONSERVATION DIVISION Wichita, Kansas						

Describe in detail the manner in which the well was plugged, indicating where the mud fluid was placed and the method or methods used in introducing it into the hole. If cement or other plugs were used, state the character of same and depth placed, from _____ feet to _____ feet for each plug set.

Made bottom hole plug back with sand to 4460', mixed and ran 3 sacks cement thru dump bailer.
 Mudded hole to 280', set 10' rock bridge. Filled hole with 4 yards ready mix from 270' to base of cellar.

(If additional description is necessary, use BACK of this sheet)

Name of Plugging Contractor Southwest Casing Pulling Co.
 Address Box 364, Great Bend, Kansas

STATE OF Kansas, COUNTY OF Barton, ss.
Southwest Casing Pulling Co. (employee of owner) or (owner or operator) of the above-described well, being first duly sworn on oath, says: That I have knowledge of the facts, statements, and matters herein contained and the log of the above-described well as filed and that the same are true and correct. So help me God.

(Signature) W. C. Spencer Sec.
Box 364, Great Bend, Kansas
 (Address)

SUBSCRIBED AND SWORN to before me this 12 day of February, 19 70

My commission expires October 1972
Sidney D. Miller Notary Public.

