


WELL PLUGGING RECORD

Give All Information Completely
Make Required Affidavit
Mail or Deliver Report to:
Conservation Division
State Corporation Commission
211 No. Broadway
Wichita, Kansas

Kingman County, Sec. 31 Twp. 29 Rge. (E) 5 (W)
Location as "NE/CNW&SW4" or footage from lines C SE NW
Lease Owner Stelbar Oil Corporation, Inc.
Lease Name Callison Well No. 1
Office Address 310 Petroleum Bldg., Wichita, Kansas
Character of Well (completed as Oil, Gas or Dry Hole) dry hole
Date well completed June 12, 1961
Application for plugging filed June 12, 1961
Application for plugging approved June 12, 1961
Plugging commenced June 12, 1961
Plugging completed June 12, 1961
Reason for abandonment of well or producing formation dry hole

NORTH

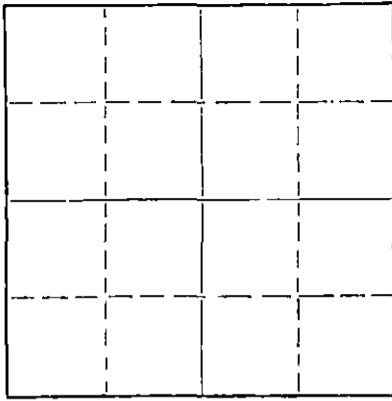

Locate well correctly on above
Section Plat

If a producing well is abandoned, date of last production 19
Was permission obtained from the Conservation Division or its agents before plugging was commenced? yes

Name of Conservation Agent who supervised plugging of this well Fred W. Hampel
Producing formation _____ Depth to top _____ Bottom _____ Total Depth of Well 4535 Feet
Show depth and thickness of all water, oil and gas formations.

OIL, GAS OR WATER RECORDS

CASING RECORD

FORMATION	CONTENT	FROM	TO	SIZE	PUT IN	PULLED OUT
				8-5/8"	270	

Describe in detail the manner in which the well was plugged, indicating where the mud fluid was placed and the method or methods used in introducing it into the hole. If cement or other plugs were used, state the character of same and depth placed, from _____ feet to _____ feet for each plug set.

Filled with mud to 240', set plug, dumped 15 sacks cement; filled with mud to 35', dumped 10 sacks cement, two sacks in rat hole

6-16-1961
RECEIVED
STATE CORPORATION COMMISSION
JUN 16 1961
CONSERVATION DIVISION
Wichita, Kansas

(If additional description is necessary, use BACK of this sheet)

Name of Plugging Contractor Stelbar Oil Corporation, Inc.
Address 310 Petroleum Bldg., Wichita, Kansas

STATE OF Kansas, COUNTY OF Sedgwick, ss.
Bertrand M. Lester, Jr., (employee of owner) or (XXXXXXXXXXXX) of the above-described well, being first duly sworn on oath, says: That I have knowledge of the facts, statements, and matters herein contained and the log of the above-described well as filed and that the same are true and correct. So help me God.

(Signature) *Bertrand M. Lester, Jr.*
310 Petroleum Bldg., Wichita, Kansas
(Address)

SUBSCRIBED AND SWORN TO before me this 15 day of June, 1961

My commission expires Jan. 18, 1961

Leona Hargrove
Leona Hargrove Notary Public.



LOG

15-095-000400000

Farm: Callison
Well No. 1
C SE NW 31-29S-5W
Kingman County, Kansas

Owner: Stelbar Oil Corporation, Inc.
Contractor: Stelbar Oil Corporation, Inc.
Commenced: May 26, 1961
Completed: June 12, 1961

8-5/8" 270' cemented with 225 sacks
Elevation: 1518 DF

0	60	Sand and gravel
60	300	Broken Lime
300	1485	Shale and Shells
1485	1672	Shale, Shells, Lime
1672	1720	Shale and Lime
1720	2723	Shale and Shells
2723	3523	Lime and Shale
3523	3539	Shale
3539	3734	Kansas City Lime
3734	3755	Lime
3755	4128	Lime and Shale
4128	4384	Mississippi Lime
4384	4489	Shale
4489	4494	Viola
4494	4511	Lime
4511	4535	Simpson
	4535	RTD, D & A

RECEIVED
STATE CORPORATION COMMISSION

JUN 16 1961

CONSERVATION DIVISION
Wichita, Kansas

Filled with mud to 240', set plug, dumped 15 sacks cement; filled with mud to 35', dumped 10 sacks cement, two sacks in rat hole.