


STATE OF KANSAS
STATE CORPORATION COMMISSION

WELL PLUGGING RECORD

Give All Information Completely
Make Required Affidavit
Mail or Deliver Report to
Conservation Division
State Corporation Comm.
245 North Water
Wichita, KS 67202

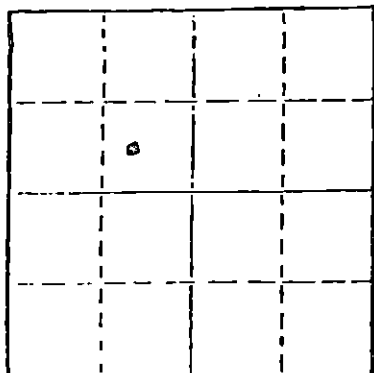

Locate well correctly on above
Section Plat

Hodgeman County. Sec. 4 Twp. 24S Rge. 26 N/W
Location as "NE/CNW 1/4 SW 1/4" or footage from lines _____
1980 FNL, 1760 FWL
Lease Owner Stauffer Oil & Gas Exploration
Lease Name Burr Well No. 1
Office Address Box 6, Liberal, KS 67901
Character of Well (Completed as Oil, Gas or Dry Hole) _____
Dry Hole

Date Well completed September 21 1984
Application for plugging filed _____ 19____
Application for plugging approved _____ 19____
Plugging commenced September 21 1984
Plugging completed September 21 1984
Reason for abandonment of well or producing formation _____

Dry
If a producing well is abandoned, date of last production _____ 19____
N/A

Was permission obtained from the Conservation Division or its agents before plugging was commenced? yes

Name of Conservation Agent who supervised plugging of this well Richard Lacey
Producing formation N/A Depth to top _____ Bottom _____ Total Depth of Well 4925
Show depth and thickness of all water, oil and gas formations.

OIL, GAS OR WATER RECORDS N/A

CASING RECORD

FORMATION	CONTENT	FROM	TO	SIZE	PUT IN	PULLED OUT
Surface				8 5/8"	284	0

Describe in detail the manner in which the well was plugged, indicating where the mud fluid was placed and the method or methods used in introducing it into the hold. If cement or other plugs were used, state the character of same and depth placed, from _____ feet to _____ feet for each plug set.

- Plug #1 1580-1480 50 sx 60/40 poz
- Plug #2 900-800 50 sx 60/40 poz
- Plug #3 310-210 40 sx 60/40 poz
- 10 sx 60/40 poz in mousehole
- 10 sx 60/40 poz in rathole


(If additional description is necessary, use BACK of this sheet)

Name of Plugging Contractor Sage Drilling / Dowell

STATE OF KANSAS COUNTY OF SEWARD, ss.
R. F. Burke, agent of owner (employee of owner) or (owner or operator) of the above-described well, being first duly sworn on oath, says: That I have knowledge of the facts, statements, and matters herein contained and the log of the above-described well as filed and that the same are true and correct. So help me God.

(Signature) R. F. Burke
R. F. Burke P. O. Box 6 Liberal, KS 67901
(Address)

SUBSCRIBED AND SWORN TO before me this 11 day of October, 19 84

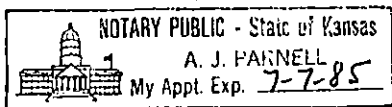

My commission expires

A. J. Parnell
Notary Public.

10-12-84

RECEIVED
STATE CORPORATION COMMISSION.

OCT 12 1984

CONSERVATION DIVISION
Wichita, Kansas