


STATE OF KANSAS
STATE CORPORATION COMMISSION

WELL PLUGGING RECORD

Give All Information Completely
Make Required Affidavit
Mail or Deliver Report to:
Conservation Division
State Corporation Commission
800 Bitting Building
Wichita, Kansas

NORTH

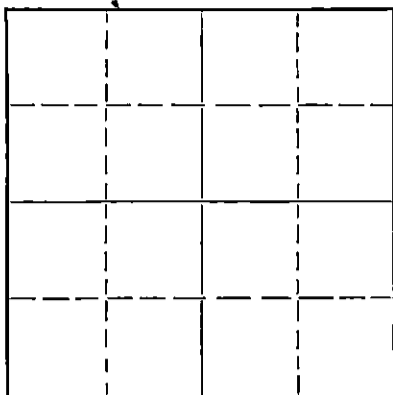

Locate well correctly on above
Section Plat

Hodgeman County. Sec. 22 Twp. 24S Rge. (E) 26 (W)
Location as "NE/CNW $\frac{1}{4}$ /SW $\frac{1}{4}$ " or footage from lines SW SW SW
Lease Owner Pabco Drilling, Inc.
Lease Name Alexander Well No. I
Office Address Wichita Kansas
Character of Well (completed as Oil, Gas or Dry Hole) dry hole
Date well completed 1-29-52 19
Application for plugging filed oral 1-29-52 19
Application for plugging approved " 1-29-52 19
Plugging commenced 1-29-52 19
Plugging completed 1-29-52 19
Reason for abandonment of well or producing formation

If a producing well is abandoned, date of last production 19
Was permission obtained from the Conservation Division or its agents before plugging was commenced? yes

Name of Conservation Agent who supervised plugging of this well D. C. Stough
Producing formation Depth to top Bottom Total Depth of Well 4985 Feet
Show depth and thickness of all water, oil and gas formations.

OIL, GAS OR WATER RECORDS

CASING RECORD

Formation	Content	From	To	Size	Put In	Pulled Out

Describe in detail the manner in which the well was plugged, indicating where the mud fluid was placed and the method or methods used in introducing it into the hole. If cement or other plugs were used, state the character of same and depth placed, from feet to feet for each plug set.

Pushed first plug to 310' and cemented with 15 sx cement. Set top plug at 35' and cemented with 10 sx cement.

2-7-52

(If additional description is necessary, use BACK of this sheet)

Name of Plugging Contractor Pabco Drilling, Inc.
Address 818 Central Building
Wichita Kansas

STATE OF Kansas, COUNTY OF Sedgwick, ss.
D. J. Briggs (employee of owner) or (owner or operator) of the above-described well,

being first duly sworn on oath, says: That I have knowledge of the facts, statements, and matters herein contained and the log of the above-described well as filed and that the same are true and correct. So help me God. PABCO DRILLING, INC.

(Signature) By D. J. Briggs
J. Briggs President
Wichita Kansas
(Address)

SUBSCRIBED AND SWORN to before me this 30th day of January 19 52

Ruth M. Sanders
Notary Public.

My commission expires March 2, 1953

PLUGGING
FILE REC-22124 R X 60
BOOK PAGE 144 LINE 38

D R I L L E R S L O G

COMPANY: Pabco Drilling, Inc.
 CONTRACTOR: Pabco Drilling, Inc.

LOCATION: SW SW SW
 22-24S-26W
 Hodgeman Co.
 Kansas

FARM NAME: NO. 1 ALEXANDER

COMMENCED: 1-8-52
 COMPLETED: 1-29-52

PRODUCTION: D & A

	8-5/8"	CASING USED:	
		317'	cem w/175 sx
Shale & Shells	175	ST OK @ 300	
Shale, Shells & Red Beds	1100	ST OK @ 600 & 1000	
Shale & Shells	1150		
Red Beds & Shale	1210		
Sand	1400		
Shale & Shells	1580	ST & SLM OK @ 1500	
Shale, Shells & Red Beds	1740		
Anhydrite	1760		
Red Beds & Shale	1955		
Shale & Shells	2195	ST & SLM OK @ 2175	
Salt & Shale	2295		
Shale, Lime & Shells	2370		
Lime & Shale	2670		
Lime	2760	ST & SLM OK @ 2750	
Lime & Shale	2880		
Lime	2950		
Lime & Shale	3015		
Lime	3840	ST & SLM OK @ 3550	
Lime & Shale	4640	ST & SLM OK @ 4300	
Lime	4837	ST & SLM OK @ 4500	
Total Depth	4985	DST @ 4833-4889	

STATE OF KANSAS)
) SS:
 COUNTY OF SEDGWICK)

I, D. J. Briggs, do hereby certify that the above is a true and correct copy of the log on the above captioned well, as shown on the daily drilling reports.


PABCO DRILLING, INC.

D. J. Briggs
 D. J. Briggs

Subscribed and sworn to before me this 30 day of January 1952.

Ruth M. Sudines
 Notary Public

My commission expires March 2, 1953 .

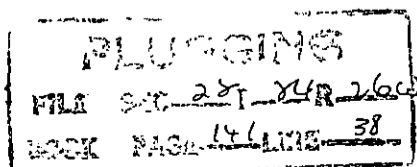

STATE OF KANSAS
 FEB 7 X 1952