

STATE OF KANSAS
STATE CORPORATION COMMISSION

WELL PLUGGING RECORD


Give All Information Completely
Make Required Affidavit
Mail or Deliver Report to:
Conservation Division
State Corporation Commission
800 Bitting Building
Wichita, Kansas

OR

FORMATION PLUGGING RECORD

Strike out upper line
when reporting plug-
ging of formations.

Gray County, Sec 9 Twp 24S Rge (E) 27(W)

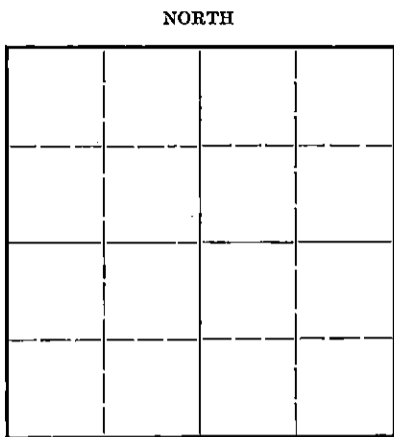

Locate well correctly on above
Section Flat

Location as "NE $\frac{1}{4}$ NW $\frac{1}{4}$ SW $\frac{1}{4}$ " or footage from lines.....
Lease Owner The Texas Company
Lease Name A. L. Seal Well No. #1
Office Address Texas Co., Box 2420 Tulsa, Oklahoma
Character of Well (completed as Oil, Gas or Dry Hole) Dry
Date well completed April 5 1945
Application for plugging filed May 5 1945
Application for plugging approved May 5 1945
Plugging commenced May 5 1945
Plugging completed May 6 1945
Reason for abandonment of well or producing formation.....

If a producing well is abandoned, date of last production..... 19

Was permission obtained from the Conservation Division or its agents before plugging was com-
menced? Yes

Name of Conservation Agent who supervised plugging of this well H. W. Kerr, Great Bend, Kansas

Producing formation..... Depth to top..... Bottom..... Total Depth of Well 5550 Feet

Show depth and thickness of all water, oil and gas formations.

OIL, GAS OR WATER RECORDS


CASING RECORD

Formation	Content	From	To	Size	Put In	Pulled Out
				13-3/8 48#SS	201'	None
				8-5/8 32#SS	2060'	"

Describe in detail the manner in which the well was plugged, indicating where the mud fluid was placed and the method or methods used in introducing it into the hold. If cement or other plugs were used, state the character of same and depth placed, from..... feet to..... feet for each plug set.

Mudded from T-D up to 200' of top. Dumped in 20 sacks cement up to 135' of top and mudded to 30' of top and dumped in 10 sacks cement to base of cellar.

PLUGGING
FILE 9-24-27W
LOG 12-26

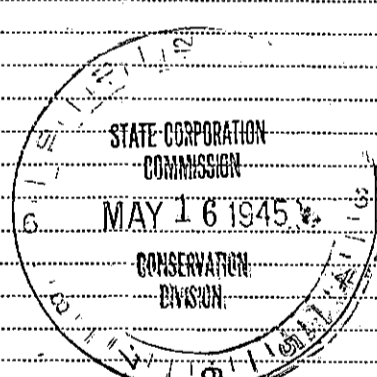

5-16-1945

(If additional description is necessary, use BACK of this sheet)

Correspondence regarding this well should be addressed to The Texas Company Producing Department
Address Box 1801, Wichita Kansas

STATE OF Kansas, COUNTY OF Sedgwick, ss.

M. C. Harrell 614 Bitting Bldg. (employee of owner) or (owner or operator) of the above-described well, being first duly sworn on oath, says: That I have knowledge of the facts, statements, and matters herein contained and the log of the above-described well as filed and that the same are true and correct. So help me God.

(Signature) M. C. Harrell
M. C. Harrell
Box 1801 Wichita, Kansas
(Address)

SUBSCRIBED AND SWORN TO before me this 16 day of May, 1945.
Bertha W. Butte
Notary Public.

My commission expires Aug. 26, 1945