

STATE OF KANSAS
STATE CORPORATION COMMISSION

WELL PLUGGING RECORD


Give All Information Completely
Make Required Affidavit
Mail or Deliver Report to:
Conservation Division
State Corporation Commission
800 Biting Building
Wichita, Kansas

R28W
NORTH

Gray County, Sec. 33 Twp. 24S Rge. 28 (E) W (W)

Location as "NE/CNW/SW" or footage from lines C NW NE
Lease Owner Deep Rock Oil Corporation
Lease Name Schartz Well No. 1
Office Address Box 1051, Tulsa, Oklahoma
Character of Well (completed as Oil, Gas or Dry Hole) Dry
Date well completed November 21 1953
Application for plugging filed November 23 1953
Application for plugging approved November 21 1953
Plugging commenced November 21 1953
Plugging completed November 21 1953
Reason for abandonment of well or producing formation Dry Hole

T24S

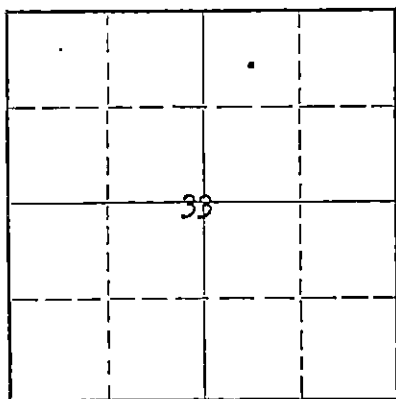

Locate well correctly on above Section Plat

If a producing well is abandoned, date of last production _____ 19____
Was permission obtained from the Conservation Division or its agents before plugging was commenced? Yes, permission obtained from M. A. Rives

Name of Conservation Agent who supervised plugging of this well M. A. Rives, Pratt, Kansas
Producing formation _____ Depth to top _____ Bottom _____ Total Depth of Well 5150 Feet
Show depth and thickness of all water, oil and gas formations.

OIL, GAS OR WATER RECORDS

CASING RECORD

FORMATION	CONTENT	FROM	TO	SIZE	PUT IN	PULLED OUT
				13-3/8"	318'	None

Describe in detail the manner in which the well was plugged, indicating where the mud fluid was placed and the method or methods used in introducing it into the hole. If cement or other plugs were used, state the character of same and depth placed, from _____ feet to _____ feet for each plug set.

Filled hole with heavy mud to 300'. Set Halliburton Wood plug at 300'. Mixed and ran 30 sacks cement from 300' to 270'. Filled hole with heavy mud to 25'. Set HOWCO Wood plug at 25'. Mixed and ran 30 sacks cement. Filled to top of pipe and into cellar.

(If additional description is necessary, use BACK of this sheet)

Name of Plugging Contractor Gabbert-Jones Drilling Company
Address 507 Orpheum Building, Wichita, Kansas

STATE OF Kansas, COUNTY OF Reno, ss.
Jack Smith (employee of owner) or (owner or operator) of the above-described well, being first duly sworn on oath, says: That I have knowledge of the facts, statements, and matters herein contained and the log of the above-described well as filed and that the same are true and correct. So help me God.

(Signature) Jack Smith

(Address)


SUBSCRIBED AND SWORN TO before me this 3rd day of December, 1953

My commission expires September 28, 1955

Alice L. Walker

Notary Public.
STATE CORPORATION COMMISSION

24-7368-5 3-53-20M

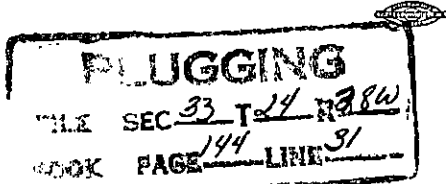

12-4-53
CONSERVATION DIVISION
Wichita, Kansas

Schartz A No. 1
 C NW/4 NE/4 Section 33-24-28
 Gray County, Kansas
 Commenced October 20, 1953
 Completed November 22, 1953

<u>Depth</u>		<u>Formation</u>
From	To	
0	100	Clay
100	200	Shale & Shells
200	215	Sand
215	318	Shale & Shells
318	560	Shale & Shells
560	705	Sand
705	900	Sand & Shale
900	1300	Shale & Shells
1300	1575	Sand
1575	1876	Sand & Shale
1876	1915	Lime
1915	1980	Lime & Shale
1980	2030	Shale
2030	2245	Shale & Shells
2245	2560	Shale & Lime
2560	2735	Lime
2735	2775	Lime & Shale
2775	3164	Lime
3164	3462	Lime & Shale
3462	3566	Lime
3566	3630	Lime & Shale
3630	3680	Lime
3680	3798	Lime & Shale
3798	4035	Lime
4035	4075	Lime & Chalk
4075	4079	Lime
4079	4095	Lime & Shale
4095	5150	Lime
5150	TD	

PLUGGING
 FILE SEC 33-24-28 R. 210
 BOOK PAGE 144 LINE 31

RECORDED
 STATE CO.

GOVERNMENT DEPARTMENT
 1953