

Give All Information Completely
Make Required Affidavit
Mail or Deliver Report to
Conservation Division
State Corporation Commission
211 No. Broadway
Wichita, Kansas

WELL PLUGGING RECORD

Gray County, Sec. 18 Twp. 24S Rge. 29W (E) (W)

Location as "NE/CNW/SW" or footage from lines C SW NW

Lease Owner Aikins & Owen

Lease Name Krug "O" Well No. 1

Office Address P. O. Box 18407- Wichita, Kansas 67218

Character of Well (completed as Oil, Gas or Dry Hole) Dry Hole

Date well completed 10/5/77 19

Application for plugging filed 10/5/77 19

Application for plugging approved 10/5/77 19


Plugging commenced 10/5/77 19

Plugging completed 10/5/77 19

Reason for abandonment of well or producing formation Dry Hole

If a producing well is abandoned, date of last production 19

Was permission obtained from the Conservation Division or its agents before plugging was commenced? Yes

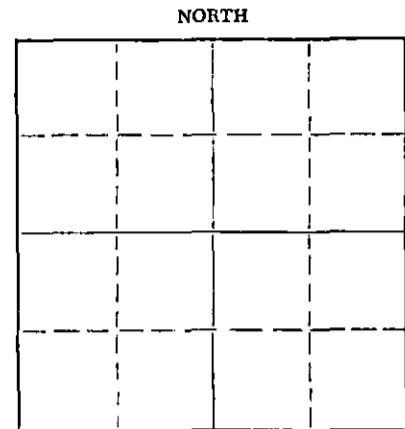

Locate well correctly on above Section Plat

Name of Conservation Agent who supervised plugging of this well Leo Massey

Producing formation _____ Depth to top _____ Bottom _____ Total Depth of Well 5010 Feet

Show depth and thickness of all water, oil and gas formations.

OIL, GAS OR WATER RECORDS

CASING RECORD

FORMATION	CONTENT	FROM	TO	SIZE	PUT IN	PULLED OUT
				8 5/8"	464'	0

Describe in detail the manner in which the well was plugged, indicating where the mud fluid was placed and the method or methods used in introducing it into the hole. If cement or other plugs were used, state the character of same and depth placed, from _____ feet to _____ feet for each plug set.

Plug @ 460' w/50 sx
Plug @ 40' w/15 sx
5 sx in rat hole
Jog complete @ 12:15 P.M. 10/5/77

10-13-77

(If additional description is necessary, use BACK of this sheet)
Name of Plugging Contractor Thunderbird Drilling, Inc.
Address P. O. Box 18407- Wichita, Kansas 67218

STATE OF KANSAS, COUNTY OF SEDGWICK, ss. Burke Krueger (employee of owner) or (owner or operator) of the above-described

well, being first duly sworn on oath, says: That I have knowledge of the facts, statements, and matters herein contained and the log of the above-described well as filed and that the same are true and correct. So help me God.

(Signature) [Signature]

P. O. Box 18407- Wichita, Kansas 67218 (Address)

SUBSCRIBED AND SWORN TO before me this 7th day of October, 1977

[Signature] Gloria DeJesus Notary Public.

My commission expires 3-25-80



D R I L L E R S L O G

Company AIKINS & OWEN

Contractor Thunderbird Drilling, Inc.

Elevation 2815' K.B.

Farm Krug. "O"

Well No. 1

Casing 8 5/8" @ 464' w/275 sx

Location C SW NW
 Sec. 18-24S-29W

Production

County Gray County, Kansas

<u>From</u>	<u>To</u>	<u>Description</u>
0	465	Surface Hole
465	990	Shale & Sand
990	1300	Shale & Red bed
1300	1319	Blaine
1319	1392	Shale
1392	1410	Blaine
1410	1480	Shale
1480	1670	Sand
1670	1950	Shale
1950	2006	Sand
2006	2030	Anhydrite
2030	2175	Sand & Shale
2175	2545	Shale w/snd. strks.
2545	3030	Shale & Shells
3030	4237	Shale & Lime
4237	4821	Lime & Shale
4821	5011	Lime
5011	RTD	
5010	LTD	

STATE OF KANSAS)
) ss.
COUNTY OF SEDGWICK)

I, Burke Krueger, of Thunderbird Drilling, Inc. upon oath states that the above and foregoing is a true and correct copy from the Daily Drilling Report from your #1 Krug "O"

Burke Krueger

Subscribed and sworn to before me this 7th day of October, 19 77

Gloria DeJesus
Gloria DeJesus Notary Public

My commission expires: 3-25-80

