


15-155-20740-0000

WELL PLUGGING RECORD

Give All Information Completely  
 Make Required Affidavit

COUNTY Reno SEC. 35 TWP. 23 RGE. 4 E/W  
 Location as in quarters or footage from lines:  
W/2 NW SW

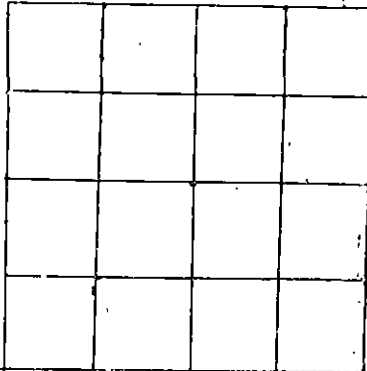

Lease Owner Kansas Energy Resources, Inc.  
 Lease Name Rudical Well No. 1  
 Office Address Box 648 1016 N. Main McPherson, Kas. 67469  
 Character of Well (Completed as Oil, Gas or Dry Hole): Oil  
 Date Well Completed \_\_\_\_\_  
 Application for plugging filed 9-24-81  
 Plugging commenced 9-15-81  
 Plugging completed 9-17-81  
 Reason for abandonment of well or producing formation Dry

Locate Well  
 correctly on above  
 Section Platt.

Was permission obtained from the Conservation Division or it's  
 Agent's before plugging was commenced? yes

Name of Conservation Agent who supervised plugging of this well Herbert Loman  
 Producing formation \_\_\_\_\_ Depth to top \_\_\_\_\_ bottom \_\_\_\_\_ T.D. 3371

Show depth and thickness of all water, oil and gas formations.

OIL, GAS OR WATER RECORDS

Casing Record

Formation	Content	From	To	Size	Put in	Pulled Out
				5 1/2"		249 to 55'

Describe in detail the manner in which the well was plugged, indicating where the mud  
 fluid was placed and the method or methods used in introducing it into the hold. If cement  
 or other plugs were used, state the character of same and depth placed, from \_\_\_\_\_ feet  
 to \_\_\_\_\_ feet for each plug set.

set Plug 3250' 5 sacks cement  
Mudded hole to 255' 15' rock bridge  
2 yds ready mix.

RECEIVED  
 STATE CORPORATION COMMISSION

CONSERVATION DIVISION  
 Wichita Kansas

Recd  
9-19-81

(If additional description is necessary, use BACK of this sheet)

Name of Plugging Contractor H. H. Coats Pulling Co.  
Box 563 Burston, Kas. 67202

STATE OF Kansas COUNTY OF Harvey, ss.  
Donald R. Hurst (employee or owner) or (owner or operator) of the  
 above-described well, being first duly sworn on oath, says: That I have knowledge of the  
 facts, statements, and matters herein contained and the log of the above-described well as  
 filed and that the same are true and correct. So help me God.

(Signature) Donald R. Hurst  
408 Circle Dr. Burston, Kas.  
 (Address)

17<sup>th</sup> day of Sept., 19 81  
Madeline Hurst  
 Notary Public.

SUBSCRIBED AND SWORN To before me this \_\_\_\_\_

