


WELL PLUGGING RECORD

Give All Information Completely
Make Required Affidavit
Mail or Deliver Report to:
Conservation Division
State Corporation Commission
P. O. Box 17027
Wichita, Kansas 67217
NORTH

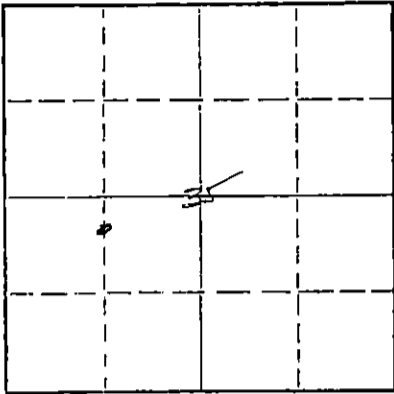

Locate well correctly on above Section Plat

Reno County, Sec. 35 Twp. 23S Rge. 4W (EXXX (W))
Location as "NE/CNW/SW" or footage from lines C N/2 N/2 SW
Lease Owner S & K Oil Company
Lease Name W. L. Adkins Well No. 7
Office Address P.O. Box 559, Tulsa, Oklahoma 74101
Character of Well (completed as Oil, Gas or Dry Hole) Dry
Date well completed 19__
Application for plugging filed 19__
Application for plugging approved July 12 19 72
Plugging commenced July 17 19 72
Plugging completed July 25 19 72
Reason for abandonment of well or producing formation

If a producing well is abandoned, date of last production 19__
Was permission obtained from the Conservation Division or its agents before plugging was commenced? Yes

Name of Conservation Agent who supervised plugging of this well Gilbert Toman
Producing formation Hunton Depth to top 388 Bottom 3588 Total Depth of Well 3588 Feet
Show depth and thickness of all water, oil and gas formations.

OIL, GAS OR WATER RECORDS

CASING RECORD

FORMATION	CONTENT	FROM	TO	SIZE	PUT IN	PULLED OUT
Hunton	None	3586 1/2	3588	10 3/4 7"	236' 3587'	None 2412.10'

Describe in detail the manner in which the well was plugged, indicating where the mud fluid was placed and the method or methods used in introducing it into the hole. If cement or other plugs were used, state the character of same and depth placed, from ___ feet to ___ feet for each plug set.

Pushed plug to 3280', sand from 3280' to 3250'
Dumped six sacks of cement with dump baylor
Set rock bridge from 215' to 200', filled surface from 200' to base of cellar with redy-mix cement

RECEIVED
STATE CORPORATION COMMISSION

AUG 30 1972

CONSERVATION DIVISION
Wichita, Kansas

(If additional description is necessary, use BACK of this sheet)
Name of Plugging Contractor Robert Self
Address R.R. #4, Hutchinson, Kansas 67501

STATE OF Kansas, COUNTY OF Reno, ss.
I Robert Self (employee of owner) or (owner or operator) of the above-described well, being first duly sworn on oath, says: That I have knowledge of the facts, statements, and matters herein contained and the log of the above-described well as filed and that the same are true and correct. So help me God.

(Signature) Robert Self
R.R. #4, Hutchinson, Kansas
(Address)

SUBSCRIBED AND SWORN TO before me this 25 day of July, 19 72

My commission expires
JOLENE G. SELF
Notary Public
Reno County, Kansas
MY COMM. EXPIRES Jan. 12, 1976

Jolene G. Self
Notary Public.

15-155-202000000

RECEIVED
STATE CORPORATION COMMISSION
JUL 12 1972
CONSERVATION DIVISION
Wichita, Kansas

ROTARY DRILLERS' LOG

OPERATOR: S & K Oil Co. & Louis Kahan DRILLING COMMENCED: April 21, 1972
P. O. Box 559
Tulsa, Oklahoma 74101

CONTRACTOR: Graves Drilling Co., Inc. DRILLING COMPLETED: April 29, 1972
505 Union Center
Wichita, Kansas 67202

CASING RECORD: 6 Jts. 236' - 10-3/4" LOCATION: Adkins No. 7
cemented with 280 sacks C N/2 N/2 SW/4
118 Jts. 3587' - 7" Section 35-23S-4W
cemented with 225 sacks Reno County, Kansas

0 - 80 Sand
80 - 244 Sand & clay
244 - 560 Salt & shale
560 - 675 Lime & shale
675 - 1000 Brokenlime & shale streaks
1000 - 1365 Lime & shale
1365 - 1835 Lime & shale streaks
1835 - 2583 Lime & shale
2583 - 2745 Lime
2745 - 2834 Lime & shale
2834 - 3040 Lime
3040 - 3155 Lime & shale
3155 - 3400 Lime
3400 - 3475 Lime & chert
3475 - 3555 Lime & shale
3555 - 3588 Shale & lime
3588 Rotary Total Depth

I hereby certify the foregoing statements to be true and correct to the best of my knowledge.

GRAVES DRILLING CO., INC.
By John Graves
President

STATE OF KANSAS)
) ss.
BUTLER COUNTY)

Subscribed and sworn to before me, a Notary Public, this 1st day of May, 1972.
My commission expires:
May 9, 1975

Betty Brandt
Betty Brandt Notary Public

Copy to Corporation Commission
Copy to Well Log Bureau