


STATE OF KANSAS  
STATE CORPORATION COMMISSION

Give All Information Completely  
Make Required Affidavit  
Mail or Deliver Report to:  
Conservation Division  
State Corporation Commission  
212 No. Market  
Wichita, Kansas

WELL PLUGGING RECORD

*Jm  
8463W*

NORTH

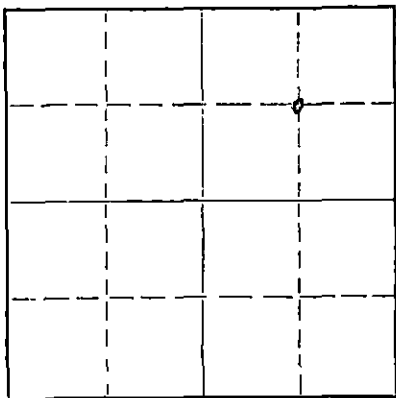

Locate well correctly on above  
Section Plat

Reno County. Sec. 35 Twp. 23S Rge. 4 (E) (W)  
Location as "NE/CNW/SW" or footage from lines C-NE/4  
Lease Owner S. & K. Oil Co.  
Lease Name Lena Krehbiel Well No. 7  
Office Address Box 682 Tulsa, Oklahoma 74101  
Character of Well (completed as Oil, Gas or Dry Hole) Dry Hole  
Date well completed Oct 23 19 67  
Application for plugging filed July 31 19 68  
Application for plugging approved August 5th 19 68  
Plugging commenced Sept. 7 19 68  
Plugging completed Sept. 13 19 68  
Reason for abandonment of well or producing formation DRY

If a producing well is abandoned, date of last production \_\_\_\_\_ 19\_\_\_\_  
Was permission obtained from the Conservation Division or its agents before plugging was commenced? Yes

Name of Conservation Agent who supervised plugging of this well Hugh Scott  
Producing formation Mississippian Depth to top 3243 Bottom 3311 Total Depth of Well 3311 Feet  
Show depth and thickness of all water, oil and gas formations.

OIL, GAS OR WATER RECORDS

CASING RECORD

FORMATION	CONTENT	FROM	TO	SIZE	PUT IN	PULLED OUT
				10 3/4"	256	- - -
				8 5/8"	564	- - - -
				5 1/2"	3307	2377.20'

Describe in detail the manner in which the well was plugged, indicating where the mud fluid was placed and the method or methods used in introducing it into the hole. If cement or other plugs were used, state the character of same and depth placed, from \_\_\_\_\_ feet to \_\_\_\_\_ feet for each plug set.

Sanded bottom of hole and dumped 5 sacks of cement. Shot pipe off at 2377.20' / Pulled pipe and mudded hole to 270'. Set rock bridge from 270' to 260'. Finished filling hole with ready-mix cement.

10-23-1968

RECEIVED  
STATE CORPORATION COMMISSION  
OCT 23 1968  
CONSERVATION DIVISION  
Wichita, Kansas

(If additional description is necessary, use BACK of this sheet)

Name of Plugging Contractor Bert Self  
Address Hutchinson, Kans.

STATE OF Kans., COUNTY OF Reno, ss.  
Employee (employee of owner) or (owner or operator) of the above-described well, being first duly sworn on oath, says: That I have knowledge of the facts, statements, and matters herein contained and the log of the above-described well as filed and that the same are true and correct. So help me God.

(Signature) Bert Self

R. R. #4, Hutchinson, Kans.  
(Address)

Subscribed and sworn to before me this 26th day of Sept., 19 68

October 13, 1969

Dorothy Self  
Notary Public.



RECEIVED  
 STATE CORPORATION COMMISSION  
 AUG 5 1968  
 CONSERVATION DIVISION  
 Wichita, Kansas  
 15-155-20019-0000

DRILLERS LOG

L. KREHBIEL NO. 7

CASING RECORD: 10-3/4" @ 256' w/275 sax cement	COMPANY: S & K OIL CO.	DESCRIPTION: C of NE Sec. 35-23S-4W Reno County, Kansas
8-5/8" @ 564' w/100 sax cement	CONTRACTOR: Sage Drilling Co.	
	COMMENCED: August 20, 1967	
	COMPLETED: August 26, 1967	
TOTAL DEPTH: 3311'		

<u>FORMATION</u>	<u>FROM</u>	<u>TO</u>	<u>REMARKS</u>
Surface Soil	0	257	
Shale & Shells	257	443	
Lime & Shale	443	1680	
Shale & Lime	1680	2585	
Lime & Shale	2585	3056	
Shale & Lime	3056	3311	5 1/2" @ 3307 1/2' w/200 sax

I certify that this is a true and correct copy of the above log to the best of my knowledge.

SAGE DRILLING CO., INC.

By Lawrence F. Gray  
 Lawrence F. Gray

Subscribed and sworn to before me this 29th day of August, 1967.

Louise K. Whitted  
 Louise K. Whitted, Notary Public

My commission expires:  
 November 26, 1970.