


15-095-00171-00-00

WELL PLUGGING RECORD

Give All Information Completely  
Make Required Affidavit  
Mail or Deliver Report to:  
Conservation Division  
State Corporation Commission  
800 Biting Building  
Wichita, Kansas

Kingman County, Sec. 18 Twp. 29S Rge. 7 (X) W (W)

NORTH

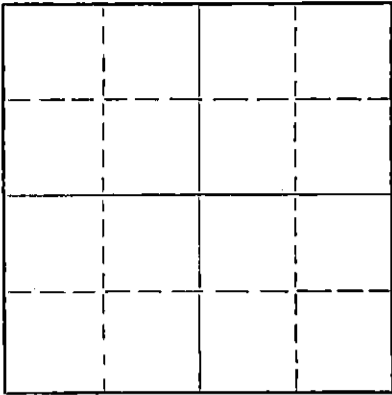

Locate well correctly on above Section Plat

Location as "NE/CNW/SW" or footage from lines \_\_\_\_\_  
Lease Owner Transit Corporation, et al.  
Lease Name Settle Well No. 1  
Office Address 1516 Liberty Bank Bldg., Okla. City, Okla.  
Character of Well (completed as Oil, Gas or Dry Hole) Dry Hole  
Date well completed 7-7-1953  
Application for plugging filed 7-7-1953  
Application for plugging approved 7-7-1953  
Plugging commenced 7-7-1953  
Plugging completed 7-7-1953  
Reason for abandonment of well or producing formation \_\_\_\_\_

If a producing well is abandoned, date of last production \_\_\_\_\_ 19\_\_\_\_  
Was permission obtained from the Conservation Division or its agents before plugging was commenced? Yes

Name of Conservation Agent who supervised plugging of this well M.A. Rives, Box 148, Pratt, Kansas  
Producing formation \_\_\_\_\_ Depth to top \_\_\_\_\_ Bottom \_\_\_\_\_ Total Depth of Well 4645 Feet  
Show depth and thickness of all water, oil and gas formations.

OIL, GAS OR WATER RECORDS

CASING RECORD

FORMATION	CONTENT	FROM	TO	SIZE	PUT IN	PULLED OUT
				8-5/8"	210'	None

Describe in detail the manner in which the well was plugged, indicating where the mud fluid was placed and the method or methods used in introducing it into the hole. If cement or other plugs were used, state the character of same and depth placed, from \_\_\_\_\_ feet to \_\_\_\_\_ feet for each plug set.

Filled hole with heavy drilling mud to 200' set plug and cemented with 20 sacks cement.  
Filled hole with heavy drilling mud to 40', set plug and cemented to bottom of cellar with 10 sacks cement.

RECEIVED  
STATE CORPORATION COMMISSION  
7-21-53  
JUL 21 1953

CONSERVATION DIVISION  
Wichita, Kansas

(If additional description is necessary, use BACK of this sheet)  
Name of Plugging Contractor Transit Corporation  
Address Oklahoma City, Okla.

STATE OF Oklahoma, COUNTY OF Oklahoma, ss.  
C. W. Dodson (employee of owner) or (owner/operator) of the above-described well, being first duly sworn on oath, says: That I have knowledge of the facts, statements, and matters herein contained and the log of the above-described well as filed and that the same are true and correct. So help me God.

(Signature) C. W. Dodson  
Oklahoma City, Okla.  
(Address)

SUBSCRIBED AND SWORN TO before me this 13 day of July, 19 53

My commission expires Feb. 14, 1953 Evelyn Sulver Notary Public.

PLUGGING  
FILE SEC 18 T 29 R 7W  
BOOK PAGE 113 LINE 32

15-095-00(71)-00-00

SOUTHWESTERN EXPLORATION CO.  
and  
TRANSIT CORPORATION

"SETTLE #1"

SE SE SE 18-29-7W  
Kingman County, Kansas

<u>FORMATION</u>	<u>FROM</u>	<u>TO</u>
Shale	0	95
Red Bed & Shells	95	210
Lime & Shells	210	305
Sand & Shale	305	370
Shale & Shells	370	1015
Shale & Lime	1015	1285
Lime & Sandy	1285	1330
Shale, Lime, Shells	1330	1385
Broken Lime	1385	1555
Lime	1555	1690
Broken Lime	1690	1855
Lime	1855	1965
Shale	1965	2000
Shale & Lime	2000	2100
Shale	2100	2370
Shale, Lime, Shells	2370	2480
Lime & Shale	2480	2680
Shale, Lime, Shells	2680	2780
Lime Topeka	2780	2840
Lime	2840	3010
Shale Black	3010	3042
Lime	3042	3105
Shale	3105	3122
Lime	3122	3176
Shale Douglas	3176	3245
Shale	3245	3252
Sand	3252	3349
Lime	3349	3390
Lime K.C.	3390	3597
Lime	3597	3630
Lime K.C.	3630	3665
Lime	3665	3789
Lime Broken	3789	3829
K.C. Lime	3829	3838
Marm. Lime & Shale	3838	3886
Sandy Shale & Lime	3886	3956
Lime & Shale	3956	4046
Shale, Lime, Shells	4046	4074
Shale Marm	4074	4110
Chert Miss.	4110	4130
Chat & Lime	4130	4140
Miss. Lime	4140	4155
Chert	4155	4165
Miss Chat	4165	4175

<u>Formation</u>	<u>From</u>	<u>To</u>
Miss. Lime	4175	4197
Lime	4197	4241
Lime	4241	4284
Shale	4284	4312
Shale	4312	4342
Chert &		
Shale	4342	4363
Shale	4363	4505
Simp. Sand.	4505	4510
Coring	4510	4520
Sand	4520	4551
Chert, Lime		
Sand	4551	4568
Sand	4568	4592
Sand, Shale		
& Lime	4592	4624
Lime	4624	4645

PLUGGING  
WELL SEC 18 T 29 R 2W  
BOOK PAGE 113 LINE 32  
RECEIVED

COMMISSION  
DIVISION

15-095-00171-00-00

SOUTHWESTERN EXPLORATION CO.--TRANSIT CORPORATION

"SETTLE #1"

ELEVATION: D.F. 1563

COMMENCED: 6-11-53

COMPLETED: 7-11-53

8-5/8" CSA at 210'. Cemented with 150 sacks cement.

I hereby certify the foregoing to be a true and accurate Driller's Log of the formations encountered in the above well.

TRANSIT CORPORATION

By:

C. W. Dodson  
C. W. Dodson

Subscribed and sworn to before me this 15th day of July, 1953.

Evelyn Culver  
Evelyn Culver, Notary Public

My commission expires Feb. 14, 1957

