


WELL PLUGGING RECORD

Give All Information Completely
Make Required Affidavit
Mail or Deliver Report to:
Conservation Division
State Corporation Commission
212 North Market, Insurance Bldg.
Wichita, Kansas

Kingman County. Sec. 18 Twp. 29S Rge. (E) 7 (W)

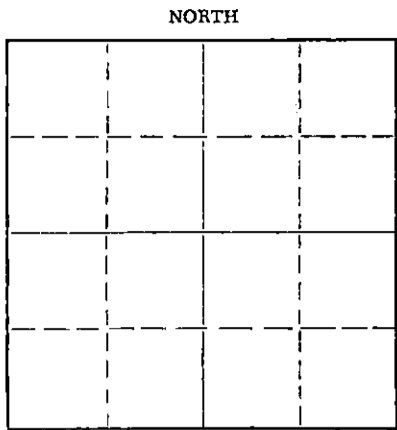

Locate well correctly on above Section Plat

Location as "NE/CNW/SW" or footage from lines C SW NE
Lease Owner Pickrell Drilling Company
Lease Name Belt Well No. 1
Office Address 705 Fourth National Bank Building, Wichita 2, Kansas
Character of Well (completed as Oil, Gas or Dry Hole) Dry Hole
Date well completed 3-19 19 59
Application for plugging filed 3-19 19 59
Application for plugging approved 3-19 19 59
Plugging commenced 3-19 19 59
Plugging completed 3-19 19 59
Reason for abandonment of well or producing formation Dry & Abandoned

If a producing well is abandoned, date of last production _____ 19 ____
Was permission obtained from the Conservation Division or its agents before plugging was commenced? Yes

Name of Conservation Agent who supervised plugging of this well W. L. Lackamp
Producing formation _____ Depth to top _____ Bottom _____ Total Depth of Well 4538' Feet
Show depth and thickness of all water, oil and gas formations.

OIL, GAS OR WATER RECORDS

CASING RECORD

FORMATION	CONTENT	FROM	TO	SIZE	PUT IN	PULLED OUT
				8 5/8"	250'	None

Describe in detail the manner in which the well was plugged, indicating where the mud fluid was placed and the method or methods used in introducing it into the hole. If cement or other plugs were used, state the character of same and depth placed, from _____ feet to _____ feet for each plug set.

Filled with heavy mud to 240', bridge hole and cement with 20 sacks cement. Then heavy mud to 40' below ground level, bridge hole and cement with 10 sacks cement to bottom of cellar.

RECEIVED
STATE CORPORATION COMMISSION

MAR 24 1959

CONSERVATION DIVISION
Wichita, Kansas

3-24-1959

(If additional description is necessary, use BACK of this sheet)

Name of Plugging Contractor Pickrell Drilling Company
Address 705 Fourth National Bank Building, Wichita 2, Kansas

STATE OF Kansas, COUNTY OF Sedgwick, ss.
C. W. Sebitt (employee of owner) or (owner or operator) of the above-described

well, being first duly sworn on oath, says: That I have knowledge of the facts, statements, and matters herein contained and the log of the above-described well as filed and that the same are true and correct. So help me God.

(Signature)

705 Fourth National Bank Building, Wichita, Ks.
(Address)

SUBSCRIBED AND SWORN TO before me this 23rd day of March, 19 59

My commission expires May 13, 1962

Mary Ellen Sampson
(Mary Ellen Sampson) Notary Public.

PLUGGING
FILE SEC. 18 T. 29 R. 7
BOOK PAGE 25 LINE 15

File Copy 15-095-00346-00-00
ROTARY DRILLING LOG

COMPANY: Pickrell Drilling Company

Rotary Drilling Commenced: 2/27/59

LOCATION: C SW NE, Sec. 18-29S-7W
Kingman County, Kansas
Belt #1

Rotary Drilling Completed: 3/19/59

CONTRACTOR: **PICKRELL DRILLING COMPANY**
Wichita, Kansas

CASING RECORD:
250' (.6 jts.) 8 5/8" 22.7# Armco Spiralweld Casing cemented with
150 sacks cement, 2% Gel. Cement circulated.

D&A, No oil string run

LOG

(Figures indicate bottom of formation — measurements from top of rotary bushing.)

Surface Soil	10'	Circ. for samples	3670'
Sand	15'		3812'
Red Rock	250'		4110'
Red Beds	575'		4118'
Shale & Shells	950'		4131'
Anhydrite	980'		4493'
Shale & Lime	1450'		4498'
Lime	1950'		4510'
Lime & Shale	2150'		4515'
Shale	2470'		4538'
Lime & Shale	2870'		
Lime	3036'		
Lime & Shale	3152'		
Lime, Shale & Sand	3315'		
Lime	3825'		
Lime & Shale	4106'		
Mississippi	4213'		
Lime & Shale	4498'		
Lime	4538' T.D.		

S.L.M. at 2000 - OK
3000 - OK
4000 - OK

Slope Test at 500' 0° Off
1500' 0° Off
2000' 0° Off
3000' 0° Off
3500' 0° Off
4000' 0° Off

RECEIVED
STATE CORPORATION COMMISSION
MAR 30 1959
CONSERVATION DIVISION
Wichita, Kansas

The undersigned, C. W. Sebitts, Attorney-in-Fact for PICKRELL DRILLING COMPANY, hereby certifies in behalf of said Company, that the above is a true and correct log of the formation encountered in drilling the above well as reflected by the Daily Drilling Reports.

PICKRELL DRILLING COMPANY
By *C. W. Sebitts*
Attorney-in-Fact

STATE OF KANSAS }
COUNTY OF SEDGWICK } ss.:

On this 23rd day of March, 1959, before me the undersigned, a Notary Public, in and for

the County and State aforesaid, personally appeared C. W. Sebitts, to me known to be the identical person who subscribed the name of PICKRELL DRILLING COMPANY to the foregoing instrument as its Attorney-in-Fact and acknowledged to me that he executed the same as his free and voluntary act and deed, and as the free and voluntary act and deed of such company, for the uses and purposes therein set forth.

Given under my hand and seal of office the day and year last above written.

My commission expires: May 13, 1963

PLUGGING
FILE SEC. 18 T. 29 R. 7W
BOOK PAGE 25 LINE 15

Mary Ellen Sampson
Notary Public
(Mary Ellen Sampson)