

STATE OF KANSAS  
STATE CORPORATION COMMISSION

Give All Information Completely  
Make Required Affidavit  
Mail or Deliver Report to:  
Conservation Division  
State Corporation Commission  
800 L. King Building  
Wichita, Kansas

WELL PLUGGING RECORD

OR

FORMATION PLUGGING RECORD

Strike out upper line  
when reporting plug-  
ging off formations.

RENO

County Sec. 35 Twp. 23S Rge. 4 (E) (W)

Location as "NE 1/4 NW 1/4 SW 1/4" or footage from lines NW SW SW/4

Lease Owner OISON OIL COMPANY

Lease Name W. L. Adkins Well No. 6

Office Address Tulsa, Oklahoma

Character of Well (completed as Oil, Gas or Dry Hole) Gas

Date well completed 12-19-19 36

Application for plugging filed 10-3-19 41

Application for plugging approved 10-4-19 41

Plugging commenced 10-6-19 41

Plugging completed 10-17-19 41

Reason for abandonment of well or producing formation No more gas.

If a producing well is abandoned, date of last production 8-28-19 41

Was permission obtained from the Conservation Division or its agents before plugging was commenced? Yes.

NORTH


Locate well correctly on above Section Plat

Name of Conservation Agent who supervised plugging of this well Ruel Durkee

Producing formation Chat Depth to top 3258 Bottom 3371 Total Depth of Well 3371 Feet

Show depth and thickness of all water, oil and gas formations.

OIL, GAS OR WATER RECORDS

CASING RECORD

Formation	Content	From	To	Size	Put In	Pulled Out
Chat	Gas	3258	3371	13"	250	None
				7"	3262	2024'

Describe in detail the manner in which the well was plugged, indicating where the mud fluid was placed and the method or methods used in introducing it into the hole. If cement or other plugs were used, state the character of same and depth placed, from \_\_\_\_\_ feet to \_\_\_\_\_ feet for each plug set.

Mudded hole from total Depth (3371) to 3265. Dumped 6 sacks of cement at 3265.  
Mudded hole to 150 ft. Dumped 20 sacks of cement at 150 ft. Mud to 8 ft. of top.  
Dumped 10 sacks of cement at base of cellar.

P. VG  
FILE 35 23 + 411  
BOOK 10 - E 24

STATE CORPORATION COMMISSION  
OCT 25 1941  
10-25-41

(If additional description is necessary, use BACK of this sheet)

Correspondence regarding this well should be addressed to S. A. Keefover  
Address BOX R, Burrton, Kansas

STATE OF Kansas, COUNTY OF RENO, ss.  
J. M. Green (employee of owner) or (owner) of the above-described well,

being first duly sworn on oath, says: That I have knowledge of the facts, statements, and matters herein contained and the log of the above-described well as filed and that the same are true and correct. So help me God.

(Signature) J. M. Green

(Address)

SUBSCRIBED AND SWORN TO before me this 22 day of Oct, 1941

G. J. Bryant Notary Public.

My commission expires 4/20/42

15-155-02831-0000

OILSON OIL COMPANY  
W. L. ADKINS # 6  
NW SW SW/4  
Sec. 35-23S-4W  
RENO COUNTY, KANSAS

COMMENCED 11-27-36  
COMPLETED 12-19-36  
ELEVATION 1466


0  
140 Sand & clay  
161 Shale & shells  
251 Shells  
283 Shale & shells  
587 Shale & lime  
757 Lime shells  
840 Shale & shells  
882 Broken lime  
912 Lime  
1035 Broken lime  
77 Lime, hard  
86 Broken lime  
1125 Lime  
92 Broken lime  
1295 Shale  
1349 Broken lime  
1635 Shale  
65 Lime shells  
1765 Shale  
1809 Lime & shale  
62 Broken lime  
70 Shale  
1924 Shale & lime  
58 Broken lime  
95 Lime  
2039 Lime & shale  
65 Lime  
90 Broken lime  
49 Shale  
2209 Shale & lime  
30 Broken lime  
55 Lime, hard  
2478 Broken lime  
2517 Sand  
72 Lime  
2600 Lime, hard  
65 Sandy lime  
2700 Broken lime  
16 Lime  
60 Broken lime  
2904 Lime

2908 Sand  
2964 Lime  
72 Sandy lime  
3012 Lime  
31 Broken lime  
78 Broken lime & shale  
3216 Shale  
20 Broken lime  
58 Shale, var.  
3278 Chat, show of gas  
3371 Chat, TOTAL DEPTH

CASING RECORD

13" OD 40# L.W. 250'  
7" OD 24# L.W. 3262'

ING  
FILE: 35 23S-4W  
BOOK 10 LINE 24

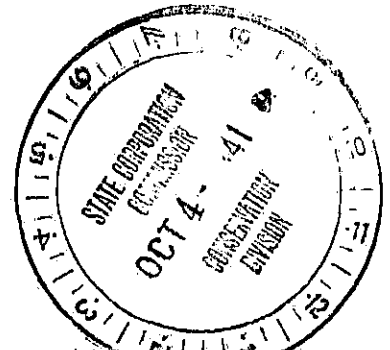

Subscribed and sworn to before me  
this 3rd day of October, 1941

G. J. Bryant  
Notary public

I hereby certify that the above is  
a true and correct copy of the log of  
W. L. Adkins # 6, NW SW SW/4, Sec. 35-  
23S-4W, Reno County, Kansas

W. A. Kefauver  
13