

STATE OF KANSAS  
STATE CORPORATION COMMISSION


Give All Information Completely  
Make Required Affidavit  
Mail or Deliver Report to:  
Conservation Division  
State Corporation Commission  
211 No. Broadway  
Wichita, Kansas

15-095-01001-0000  
WELL PLUGGING RECORD

Kingman County, Sec. 6 Twp. 29S Rge. (E) 6 (W)

Location as "NE/CNW%SW%" or footage from lines C SE SE  
Lease Owner Thunderbird Drilling, Inc.  
Lease Name Garber Well No. 1  
Office Address 712 Union Center, Wichita 2, Kansas  
Character of Well (completed as Oil, Gas or Dry Hole) Dry Hole  
Date well completed September 10 19 60  
Application for plugging filed September 10 19 60  
Application for plugging approved September 10 19 60  
Plugging commenced September 10 19 60  
Plugging completed September 10 19 60  
Reason for abandonment of well or producing formation Dry Hole

NORTH

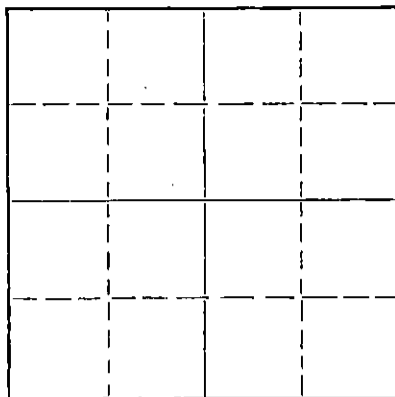

Locate well correctly on above  
Section Plat

If a producing well is abandoned, date of last production 19  
Was permission obtained from the Conservation Division or its agents before plugging was commenced? Yes

Name of Conservation Agent who supervised plugging of this well Fred Hampel  
Producing formation \_\_\_\_\_ Depth to top \_\_\_\_\_ Bottom \_\_\_\_\_ Total Depth of Well 4137 Feet  
Show depth and thickness of all water, oil and gas formations.

OIL, GAS OR WATER RECORDS

CASING RECORD

FORMATION	CONTENT	FROM	TO	SIZE	PUT IN	PULLED OUT

Describe in detail the manner in which the well was plugged, indicating where the mud fluid was placed and the method or methods used in introducing it into the hole. If cement or other plugs were used, state the character of same and depth placed, from \_\_\_\_\_ feet to \_\_\_\_\_ feet for each plug set.

Filled hole to 200' with mud. Set plug at 200'. Mix 20 sacks through drill pipe. Set plug at 40'. 10 sacks cement.

STATE CORPORATION COMMISSION  
SEP 15 1960 09-15-60  
CONSERVATION DIVISION  
Wichita, Kansas

(If additional description is necessary, use BACK of this sheet)  
Name of Plugging Contractor Thunderbird Drilling, Inc.  
Address 712 Union Center, Wichita 2, Kansas

STATE OF Kansas, COUNTY OF Sedgwick, ss.  
Charles W. Aikins, Jr. (owner or operator) of the above-described well, being first duly sworn on oath, says: That I have knowledge of the facts, statements, and matters herein contained and the log of the above-described well as filed and that the same are true and correct. So help me God.  
(Signature) Charles W. Aikins, Jr., President  
712 Union Center, Wichita 2, Kansas (Address)

SUBSCRIBED AND SWORN TO before me this 14th day of September, 19 60  
Rose Marie Kuhlman Notary Public.  
My commission expires February 1, 1964



DRILLERS LOG

#1 Garber

LOCATION: C SE SE - Section 6  
Township 29 South, Range 6 West,  
Kingman County, Kansas

CONTRACTOR: Thunderbird Drilling, Inc.  
712 Union Center  
Wichita 2, Kansas

DRILLING COMMENCED: August 29, 1960

DRILLING COMPLETED: September 10, 1960

ELEVATION: 1553' K. B.  
1550' D. F.  
1548' G. L.

SURFACE CASING: 8-5/8" surface casing set at 223'  
with 190 sacks cement, 2% gel,  
4 sacks calcium chloride.

WELL LOG

0 - 40	Sand
40 - 750	Red Bed and Shale
750 - 1574	Shale and Lime
1574 - 1820	Lime
1820 - 1945	Lime and Shale
1945 - 2565	Shale
2565 - 2947	Shale and Lime
2947 - 3045	Lime
3045 - 3195	Shale and Lime
3195 - 3277	Lime and Shale
3277 - 3445	Lime
3445 - 3514	Lime and Shale
3514 - 4055	Lime
4055 - 4064	Chert
4064 - 4137	Lime
4137	Total Depth


RECEIVED  
COMMISSION  
SEP 15 1960  
CONSULTING DIVISION  
Wichita, Kansas

The undersigned, Charles W. Aikins, Jr., President of Thunderbird Drilling, Inc., hereby certifies that the above is a true and correct log of the formations encountered in the drilling of the #1 Garber as shown in the daily drilling reports.

THUNDERBIRD DRILLING, INC.

  
Charles W. Aikins, Jr., President

Subscribed and sworn to before me this 14th day of September, 1960.

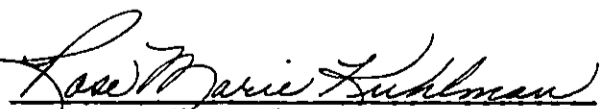  
Rose Marie Kuhlman, Notary Public

My commission expires 2-1-64.