


Give All Information Completely  
Make Required Affidavit  
Mail or Deliver Report to:  
Conservation Division  
State Corporation Commission  
212 No. Market  
Wichita, Kansas

WELL PLUGGING RECORD

NORTH

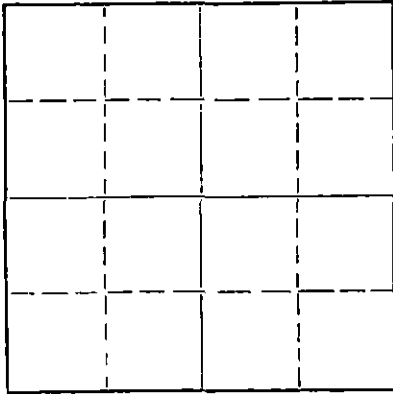

Locate well correctly on above  
Section Plat

Kingman County, Sec. 29 Twp. 29S Rge. ~~4E~~ 5 (W)  
Location as "NE/CNW/SW" or footage from lines Ctr NE SW  
Lease Owner Texaco Inc.  
Lease Name Clara Ward Well No. 1  
Office Address 614 Bitting Bldg., Wichita, Kansas 67202  
Character of Well (completed as Oil, Gas or Dry Hole) Dry Hole  
Date well completed 1-12-1966  
Application for plugging filed Attached 1966  
Application for plugging approved Verbal 1-13-1966  
Plugging commenced 1-11-1966  
Plugging completed 1-11-1966  
Reason for abandonment of well or producing formation Dry Hole

If a producing well is abandoned, date of last production Dry Hole 1966  
Was permission obtained from the Conservation Division or its agents before plugging was commenced? Yes

Name of Conservation Agent who supervised plugging of this well A. Elving, Box 248, Pratt, Kansas  
Producing formation Dry Hole Depth to top \_\_\_\_\_ Bottom \_\_\_\_\_ Total Depth of Well 4578 Feet  
Show depth and thickness of all water, oil and gas formations.

OIL, GAS OR WATER RECORDS

CASING RECORD

FORMATION	CONTENT	FROM	TO	SIZE	PUT IN	PULLED OUT
Dry Hole				8-5/8	274'	None

Describe in detail the manner in which the well was plugged, indicating where the mud fluid was placed and the method or methods used in introducing it into the hole. If cement or other plugs were used, state the character of same and depth placed, from \_\_\_\_\_ feet to \_\_\_\_\_ feet for each plug set.

Hole plugged as follows: 4578-270 w/hvy mud,  
270-200 w/cmt,  
200-40 w/hvy mud,  
40-surface w/cmt,  
Comp. 11 PM 1-11-66

STATE CORPORATION COMMISSION  
WICHITA, KANSAS

02-21-66

FEB 21 1966

CONSERVATION DIVISION  
Wichita, Kansas

(If additional description is necessary, use BACK of this sheet)

Name of Plugging Contractor Garvey Drilling Company  
Address 352 North Broadway, Wichita, Kansas

STATE OF KANSAS, COUNTY OF SEDGWICK, ss.  
H. N. Wade (employee of owner) or (~~owner~~) of the above-described well, being first duly sworn on oath, says: That I have knowledge of the facts, statements, and matters herein contained and the log of the above-described well as filed and that the same are true and correct. So help me God.

(Signature) [Signature]  
614 Bitting Building, Wichita, Kansas  
(Address)

SUBSCRIBED AND SWORN TO before me this 17th day of February, 1966

[Signature]  
Notary Public.

My commission expires 10-13-69

# WELL LOG

15095-30077 0000

COMPANY Texaco, Inc.

SEC. 29 T. 29S R. 5W

FARM Clara Ward

NO. 1

LOC. NE SW


TOTAL DEPTH 4578'

COUNTY Kingman

COMM. 12-30-65

COMP. 1-12-66

CONTRACTOR Garvey Drilling Company

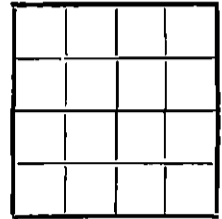

CASING 8 5/8" @ 275' w/225 sx

ELEVATION

PRODUCTION D & A

FIGURES INDICATE BOTTOM OF FORMATIONS

- 40' Sand and Red Bed
- 275' Red Bed and Shale
- 640' Shale and Shells
- 845' Shale
- 2285' Lime and Shale
- 2879' Shale and Lime
- 3544' Lime and Shale
- 3895' Lime
- 4185' Lime and Shale
- 4316' Lime
- 4378' Shale and Lime
- 4460' Lime with Shale
- 4515' Shale with Lime
- 4525' Lime and Shale
- 4578' Simpson Sand
- 4578' RTD

RECEIVED  
STATE CORPORATION COMMISSION

FEB 21 1966

CONSERVATION DIVISION  
Wichita, Kansas

State of Kansas }  
County of Barton } SS

I, Sam N. Stephens of Garvey Drilling Company

upon oath state the above and foregoing is a true and correct copy of the log of the Clara Ward No. 1 well.

Sam N. Stephens

Subscribed and sworn to before me this 24th day of January 19 66

My Commission Expires: November 5, 1969

Richard A. Day  
NOTARY PUBLIC