


15-095-01204-0000

WELL PLUGGING RECORD

Give All Information Completely
 Make Required Affidavit

COUNTY Kingman SEC. 30 TWP. 29S RGE. 5 W
 Location as 4th quarters or footage from lines:
NE-NE-SW

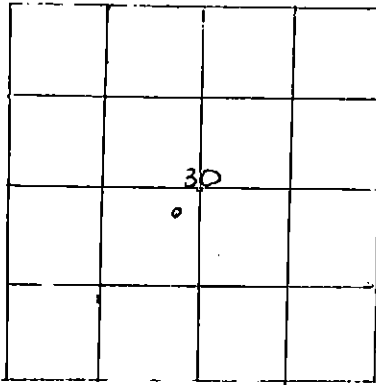

Locate Well
 correctly on above
 Section Platt.

Lease Owner Texaco
 Lease Name Drisher Well No. #3
 Office Address P.O. Box 2420, Tulsa, OK 74102
 Character of Well (Completed as Oil, Gas or Dry Hole): Oil
 Date Well Completed 7-21-55
 Application for plugging filed 10-29-82
 Plugging commenced 6-8-83
 Plugging completed 6-9-83
 Reason for abandonment of well or producing formation Depleted

Was permission obtained from the Conservation Division or it's
 Agent's before plugging was commenced? Yes

Name of Conservation Agent who supervised plugging of this well Dist #2 office
 Producing formation Simpson Depth to top 4454 bottom T.D. 2465'
 Show depth and thickness of all water, oil and gas formations.

OIL, GAS OR WATER RECORDS

Casing Record

Formation	Content	From	To	Size	Put in	Pulled Out
				7"	4462'	1170'

Describe in detail the manner in which the well was plugged, indicating where the mud
 fluid was placed and the method or methods used in introducing it into the hold. If cement
 or other plugs were used, state the character of same and depth placed, from _____ feet
 to _____ feet for each plug set

Bridge in Pipe at 1300' Cased 9.5" Cement
Shot Pipe loose at 1170' Layer Pipe Down.

RECEIVED
 STATE CORPORATION COMMISSION

JUL 05 1983

CONSERVATION DIVISION
 Wichita, Kansas


(If additional description is necessary, use BACK of this sheet)

Name of Plugging Contractor B+S Well Service, Inc.

STATE OF Kansas COUNTY OF Cowley, ss.
DALE Smith (employee of owner) or (owner or operator) of the
 above-described well, being first duly sworn on oath, says: That I have knowledge of the
 facts, statements, and matters herein contained and the log of the above-described well as
 filed and that the same are true and correct. So help me God.

(Signature) [Signature]
Wingfield, KS.
 (Address)

SUBSCRIBED AND SWORN TO before me this 14th day of June, 19 83

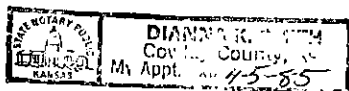

Dianna K. Smith
 Dianna K. Smith Notary Public.

My Commission expires: 04-05-85

15095-01204-0000

The Texas Company
Tulsa, Oklahoma

Tulsa, Oklahoma
July 12, 1955

CONTRACTOR: Stickle Drilling Company
Drilling Commenced: June 17, 1955
Drilling Completed: July 7, 1955

Jake Graber #3 NE NE SW
Section 30-29S-5W,
Kingman County, Kansas.

DRILLERS LOG

Sand	0-160
Red Rock & Shale	160-290
Shale & Shells	290-552
Shale & Sand	552-700
Shale	700-920
Anhydrite	920-945
Shale & Shells	945-1095
Lime & Shale	1095-1280
Lime	1280-1550
Lime & Shale	1550-1675
Shale & Lime	1675-1985
Shale & Shells	1985-2125
Shale & Lime	2125-2310
Shale & Shells	2310-2340
Lime & Shale	2340-2494
Shale & Lime	2494-2615
Lime & Shale	2615-3165
Sandy Shale	3165-3197
Sand & Shale	3197-3298
Lime & Shale	3298-3429
Shale & Lime	3429-3528
Lime & Shale	3528-3670
Lime	3670-3709
Lime & Shale	3709-3864
Shale & Lime	3864-4092
Chat	4092-4147
Lime	4147-4295
Lime & Shale	4295-4324
Shale & Lime	4324-4462 TD

RECEIVED
STATE DEPARTMENT OF CONSERVATION

OCT 18 1982

CONSERVATION DIVISION
Wichita, Kansas

I, Frank E. Stickle hereby certify the above to be a true and complete
Drillers Log of The Texas Company's Jake Graber #3 NE NE SW Section 30-
29S-5W, Kingman County, Kansas.

Frank E. Stickle
Frank E. Stickle

Lillian T. Bonham
Notary Public

February 13, 1956
My Commission Expires