

15-095-01235000

Give All Information Completely
Make Required Affidavit
Mail or Deliver Report to:
Conservation Division
State Corporation Commission
211 No. Broadway
Wichita, Kansas

WELL PLUGGING RECORD

Kingman County. Sec. 30 Twp. 29S Rge. 5W (E) (W)

Location as "NE/CNW/SW" or footage from lines 150S Ctr SW NW

Lease Owner Texaco Inc.

Lease Name B. J. Stucky Well No. 2

Office Address 614 Bitting Bldg., Wichita, Kansas

Character of Well (completed as Oil, Gas or Dry Hole) Dry Hole

Date well completed 4-29- 19 63

Application for plugging filed Verbally Approved 5-2- 19 63

Application for plugging approved 4-28 19 63


Plugging commenced 4-28 19 63

Plugging completed 4-28 19 63

Reason for abandonment of well or producing formation Dry Hole

If a producing well is abandoned, date of last production _____ 19 _____

Was permission obtained from the Conservation Division or its agents before plugging was commenced? Yes

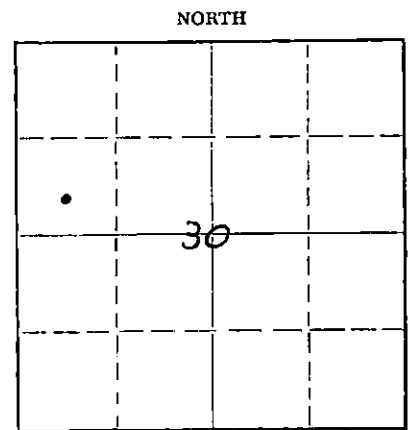

Locate well correctly on above Section Plat

Name of Conservation Agent who supervised plugging of this well Archie Elving-Pratt, Kansas

Producing formation Dry Hole Depth to top _____ Bottom _____ Total Depth of Well 4493 Feet

Show depth and thickness of all water, oil and gas formations.

OIL, GAS OR WATER RECORDS

CASING RECORD

FORMATION	CONTENT	FRDM	TO	SIZE	PUT IN	PULLED OUT
Dry Hole				8-5/8	212	None

Describe in detail the manner in which the well was plugged, indicating where the mud fluid was placed and the method or methods used in introducing it into the hole. If cement or other plugs were used, state the character of same and depth placed, from _____ feet to _____ feet for each plug set.

Hole plugged as follows: 4493'-180' heavy mud, 180'-124' rock bridge and 20 sacks cement, 124'-40' heavy mud, 40'-surface 10 sacks cement.

RECEIVED
STATE CORPORATION COMMISSION

MAY 20 1963

CONSERVATION DIVISION
Wichita, Kansas

(If additional description is necessary, use BACK of this sheet)

Name of Plugging Contractor Garvey Drilling Company
Address 352 North Broadway, Wichita, Kansas

STATE OF Kansas COUNTY OF Sedgwick, ss.
H. N. Wade (employee of owner) or (owner or operator) of the above-described

well, being first duly sworn on oath, says: That I have knowledge of the facts, statements, and matters herein contained and the log of the above-described well as filed and that the same are true and correct. So help me God.

(Signature) [Signature]

614 Bitting Bldg., Wichita, Kansas
(Address)

SUBSCRIBED AND SWORN TO before me this 16th day of May, 19 63

A.E. Boyd
Notary Public.

My commission expires 6-20-64



WELL LOG

15-095-01235-0000

COMPANY **Texaco Inc**

SEC. **30 T. 29S R. 5W**

FARM **Stucky**

NO. **2**

LOC. **SW NW**


TOTAL DEPTH **4493'**

COUNTY **Kingman**

COMM. **4-15-63**

COMP. **4-23-63**

CONTRACTOR **Garvey Drilling Company**

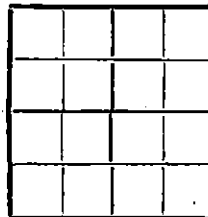

CASING **8 5/8" @ 211.70' w/200 sx**

ELEVATION

PRODUCTION **D & A**

FIGURES INDICATE BOTTOM OF FORMATIONS

- 60' Clay
- 212' Red Bed
- 275' Red Bed and Shale
- 920' Shale
- 943' Anhydrite
- 1400' Shale and Shells
- 1485' Shale and Lime
- 1880' Lime
- 2315' Shale and Lime
- 3598' Lime and Shale
- 3995' Lime
- 4050' Lime and Shale
- 4100' Shale and Lime
- 4130' Chert
- 4155' Chert, Lime and Shale
- 4235' Lime
- 4305' Mississippi Lime
- 4335' Lime
- 4395' Mississippi
- 4435' Lime
- 4480' Shale and Lime
- 4484' Lime
- 4493' Simpson Shale
- 4493' RTD

RECEIVED
STATE CORPORATION COMMISSION

MAY 20 1963

CONSERVATION DIVISION
Wichita, Kansas

State of Kansas } ss

County of Barton }

I, Sam N. Stephens of Garvey Drilling Company

upon oath state the above and foregoing is a true and correct copy of the log of the Stucky #2 well.

Sam N. Stephens

Subscribed and sworn to before me this 30th day of April 19 63

My Commission Expires: October 24th, 1966

Brantford
NOTARY PUBLIC

TEXACO INC.—LOG OF WELL

Tulsa

DIVISION

15-09501235000

640 ACRES
N

INDICATE EXACT WELL LOCATION & LEASE BOUNDARY WITHIN SECTION

WELL B. J. Stucky L. D. FILE NO. 153715

LOC. 150'S of Ctr. SW NW SEC. 30 TWP. 29S RGE. 5W

DIST. Wichita CO.-PARISH Kingman STATE Kansas

COMM. DRLG. 4-15-63 COMP. DRLG. 4-27-63 DAYS DRLG. 13

ROT. FROM 0 TO 4493 CABLE FROM _____ TO _____

CONTR., OR CO. RIG NO. Garvey Drilling Co. T. D. DRILLED 4493

COMP. T. D. Dry Hole ZERO ELEV. KB 1514 GRD. ELEV. 1506 CSG. FLG. ELEV. _____

DATE OF FIRST PROD. Dry hole OFFICIAL COMP. DATE 4-29-63

LOGS RUN Gamma Log

CASING RECORD

SIZE INCHES	DEPTH FEET	WEIGHT #/FT.	GRADE	RANGE	REMARKS—QUAN. CMT., TEMP. SURV., ETC.
8-5/8	212	28.5#			Set and Cmtd. 8-5/8" Csg @ 212 W/200 sks pozmix 2% CaCl ₂ Cmt. Circ.

COMPLETION DATA

FORMATION	Dry Hole			
DATE OF TEST				
DEPTH OF PROD. INTERVAL				
INITIAL PRODUCTION:	OIL - BPD			
	GAS - MCF			
	WATER - BPD			
	GOR			
	BHP - PSI			
CORRECTED API GRAVITY				
PRODUCING CONDITIONS				
ARTIFICIAL STIMULATION				

RECEIVED
STATE CORPORATION COMMISSION
MAY 20 1963
CONSERVATION DIVISION
Wichita, Kansas

REMARKS

1

WELL B. J. Stucky #2 FIELD Orsenus AREA Winfield