

15-095-01281-0000

STATE OF KANSAS
STATE CORPORATION COMMISSION

Give All Information Completely
Make Required Affidavit
Mail or Deliver Report to:
Conservation Division
State Corporation Commission
212 North Market, Insurance Bldg.
Wichita, Kansas

WELL PLUGGING RECORD

Kingman County, Sec. 30 Twp. 29 Rge. 5 (E) W (W)
Location as "NE/CNW/SW" or footage from lines ctr Sx NW 9B


Lease Owner Texaco, Inc.
Lease Name G.V. Panner Well No. 2

Office Address 614 Bittin Building, Wichita, Kansas
Character of Well (completed as Oil, Gas or Dry Hole) Dry Hole

Date well completed 1-16 19 59
Application for plugging filed 3-2 19 59
Application for plugging approved 3-3 19 59
Plugging commenced 3-3 19 59
Plugging completed 3-9 19 59

Reason for abandonment of well or producing formation well Drilled dry

If a producing well is abandoned, date of last production 19
Was permission obtained from the Conservation Division or its agents before plugging was commenced? yes

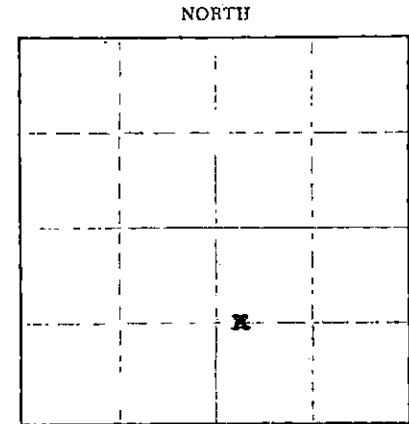

Locate well correctly on above Section Plat

Name of Conservation Agent who supervised plugging of this well Fred W. Hampel, Pratt, Kansas
Producing formation _____ Depth to top _____ Bottom _____ Total Depth of Well TD 4483 Feet

Show depth and thickness of all water, oil and gas formations. PB -TD 4477

OIL, GAS OR WATER RECORDS

CASING RECORD

FORMATION	CONTENT	FROM	TO	SIZE	PUT IN	PULLED OUT
				10 3/4"	500'	none
				7"	4485'	3391

Describe in detail the manner in which the well was plugged, indicating where the mud fluid was placed and the method or methods used in introducing it into the hole. If cement or other plugs were used, state the character of same and depth placed, from _____ feet to _____ feet for each plug set.

- 4477 - 4215 PB w/100 ex reg cement
 - 4215 - 200 mud
 - 200 - 150 20 ex cement
 - 150 - 35 Heavy mud
 - 35 - 0 15 ex cement
- Cut off surface pipe & welded steel plate on top.

RECEIVED
STATE CORPORATION COMMISSION

2000
04-02-63 APR 2 1963

CONSERVATION DIVISION
Wichita, Kansas

(If additional description is necessary, use BACK of this sheet)

Name of Plugging Contractor Smith & Smith Pipe Pulling Co.
Address Box 1022, Duncan, Oklahoma

STATE OF Kansas, COUNTY OF Sedgwick, ss.
M.C. Harrell (employee of owner) or (owner or operator) of the above-described well, being first duly sworn on oath, says: That I have knowledge of the facts, statements, and matters herein contained and the log of the above-described well as filed and that the same are true and correct. So help me God.

(Signature) M.C. Harrell
614 Bittin g Building, Wichita, Kansas
(Address)

SUBSCRIBED AND SWORN TO before me this 22nd day of May, 19 59

My commission expires September 20, 1960

Notary Public.

15-095-01281-0000

The Texas Company
Tulsa, Oklahoma

Tulsa, Oklahoma
December 21, 1955

CONTRACTOR: Stickle Drilling Company
Drilling Commenced: November 30, 1955
Drilling Completed: December 19, 1955

O.W. Tanner #2 SW NW SE
Section 30-29S-5W, Kingman
County, Kansas.

DRILLERS LOG

Sand	0-60
Sand & Shale	60-100
Red Bed & Shale	100-370
Shale & Shells	.370-1014
Anhydrite	1014-1045
Shale & Shells	1045-1330
Lime & Shale	1330-1583
Shale & Lime	1583-2100
Shale & Lime Streaks	2100-2350
Shale & Shells	2350-2385
Shale & Lime	2385-3515
Lime & Shale	3515-3588
Lime	3588-3753
Shale & Lime	3753-3819
Lime & Shale	3819-3909
Shale & Lime	3909-4067
Lime	4067-4195
Mississippi Lime	4195-4235
Lime	4235-4347
Shale & Lime	4347-4453
Lime	4453-4481 TD

I, Frank E. Stickle hereby certify the above to be a true and complete Drillers Log of The Texas Company's O. W. Tanner #2 SW NW SE Section 30-29S-5W, Kingman County, Kansas.

Frank E. Stickle
Frank E. Stickle

William J. Johnson
Notary Public

February 13, 1956
My Commission Expires

RECEIVED
STATE CORPORATION COMMISSION

APR 1 1956

CONSERVATION DEPARTMENT
Wichita, Kansas

LOG OF WELL

File
15-095-01281-0000
FORM 10 - 1954 (REVISED 5-1-55)

O. W. TANNER NO. 2

SHEET 1

OWNER The Texas Company DIVISION Oklahoma DATE MADE January 19, 1956
 DISTRICT Kansas LEASE O. W. Tanner WELL NO. 2
 STATE Kansas COUNTY OR PARISH Kingman TWP. 29S RANGE 5W SEC. 30
 LOCATION OF WELL SW NW SE

COMMENCED RIGGING UP 11-30-55 COMMENCED DRILLING 12-1-55 COMPLETED DRILLING 1-13-56
 DAY DRILLER _____ NIGHT DRILLER _____ CONTRACTOR Stickle Drlg. Co.
 CABLE FROM 4481' TO 4483' ROTARY FROM 0' TO 4481' COMPANY RIG NO. _____
 TOTAL DEPTH 4483' MEASURED BY M. C. Harrell ELEVATION KB - 1516'
PBTD 4477'

CASING RECORD

SIZE	WEIGHT	PUT IN WELL		PULLED OUT		LOST IN WELL		SHOES		PACKERS		SET AT
		FEET	INS.	FEET	INS.	FEET	INS.	LENGTH	MAKE	KIND	LENGTH	
10-3/4"	32.75#	500'				(R-2, H-40,		new casing)				FT.
7"	23#	516'				(R-2, J-55,		new casing)				FT.
7"	20#	3969'				(R-2, J-55,		new casing)				FT.
												FT.
												FT.
10-3/4" casing set at 498' with 450 sacks cement, 2% CC. Cement did not circulate. Ran 25 sacks cement down annulus, filled up to surface. 7" casing set at 4481' with 200 sacks cement.												

WAS CASING CEMENTED? _____ IF SO, HOW MANY SACKS OF CEMENT USED? _____
 LINER: STATE SIZE AND WEIGHT _____ WHERE SET _____ FT. AND INS. BLANK _____ FT. AND INS. PERFORATED _____
 HOW PUT TOGETHER _____ COUPLING _____ FLUSH-JOINT _____ INSERTED _____
 REMARKS: _____

EQUIPMENT RECORD

TUBING				SUCKER RODS			PUMPING OUTFIT
SIZE	WEIGHT	FEET	INS.	FEET	INS.	SIZE AND KIND	DESCRIPTION, KIND, SIZE, ETC.

RECEIVED
STATE CORPORATION

FLOWING, PUMPING, GASSEY OR DRY Dry PRODUCTION FIRST 24 HOURS _____ PRODUCTION SETTLED APR 2 1963
 IF GAS WELL, OPEN FLOW CAPACITY _____ SHUT IN PRESSURE _____ ROCK PRESSURE _____
 KIND OF SHOT _____ SIZE OF SHOT, QUARTS _____
 NUMBER OF SHELLS _____ SIZE OF SHELLS _____ INCHES, DIAMETER _____
 LENGTH OF SHELLS _____ FEET _____ INCHES _____ TOP OF SHOT _____
 BOTTOM OF SHOT _____ ANCHOR _____ WELL BRIDGED TO _____
 TOTAL DEPTH OF WELL _____ NUMBER OF SHOT _____ PRODUCTION BEFORE SHOT _____ BBLs. PER DAY _____
 PRODUCTION AFTER SHOT _____ BBLs. PER DAY. SHOT FURNISHED BY _____
 NAME OF SHOOTER _____ SHOT INSPECTED _____ BY _____ (COMPANY EMPLOYEE)
 COMMENCED DRILLING DEEPER _____ COMPLETED _____ DRILLING DEEPER _____

TOTAL DEPTH _____ PRODUCTION FIRST 24 HOURS _____ PRODUCTION SETTLED _____
 REMARKS: O. W. Tanner #2
Orsemus Pool
TD 4483' - PBTD 4477'
Completed Drilling 1-13-56

NOTE: IF WELL WAS DRY, STATE UNDER REMARKS, WHEN, HOW, AND BY WHOM PLUGGED.
 STATE UNDER REMARKS ANYTHING OF INTEREST NOT COVERED IN LOG.
 IF THE SPACE PROVIDED FOR REMARKS IS NOT SUFFICIENT WRITE ON BOTTOM OF LAST SHEET OF LOG.

TOTAL NUMBER OF SHEETS _____

\$5.25 - \$600 - \$550 - Waiting \$350