


Give All Information Completely  
Make Required Affidavit  
Mail or Deliver Report to  
Conservation Division  
State Corporation Commission  
311 No. Market  
Wichita, Kansas

WELL PLUGGING RECORD

15-095-20229000

NORTH

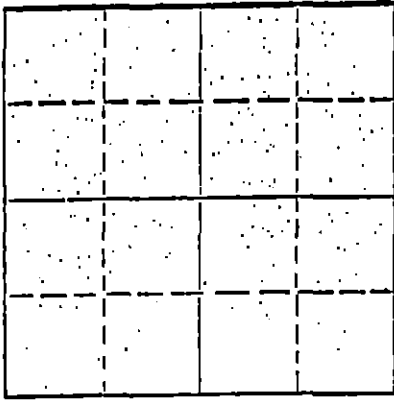

Locate well correctly on above  
Section Plat

Kingman County, Sec. 30 Twp. 29 Rge. 5 (E) (W) X  
Location as "NE/CNW/SE/SW" or footage from lines. SW SE NW  
Lesse Owner American Drilling Company, Ltd.  
Lesse Name Stucky Well No. 1  
Office Address 360 Sutton Place Wichita, Kansas 67202  
Character of Well (completed as Oil, Gas or Dry Hole)  
Date well completed 10  
Application for plugging filed 2-9-71 10  
Application for plugging approved 2-10-71 10  
Plugging commenced 2-10-71 10  
Plugging completed 2-12-71 10  
Reason for abandonment of well or producing formation

If a producing well is abandoned, date of last production 10  
Was permission obtained from the Conservation Division or its agents before plugging was commenced? Yes

Name of Conservation Agent who supervised plugging of this well Howard Hess  
Producing formation Depth to top Bottom Total Depth of Well 4455 Feet  
Show depth and thickness of all water, oil and gas formations.

OIL, GAS OR WATER RECORDS

CASING RECORD

FORMATION	CONTENT	FROM	TO	SIZE	PUT IN	PULLED OUT
				8 5/8	306	None
				4 1/2	4416	4009'.90

Describe in detail the manner in which the well was plugged, indicating where the mud fluid was placed and the method or methods used in introducing it into the hole. If cement or other plugs were used, state the character of same and depth placed, from feet to feet for each plug set.

Pushed plug to 4200'; dumped 25' of sand and 4 sacks of cement.  
Shot casing at 4175', 4080' and 3985'. Laid down 131 joints of  
4 1/2" casing. Set rock bridge at 300' and dumped 4 yards of  
ready mix concrete.


RECEIVED  
STATE CORPORATION COMMISSION  
FEB 26 1971  
CONSERVATION DIVISION  
Wichita, Kansas

(If additional description is necessary, use BACK of this sheet)  
Name of Plugging Contractor Forbes Casing Pulling Company, Inc.  
Address P. O. Box 221 Great Bend, Kansas 67530

STATE OF Kansas COUNTY OF Barton ss.  
James W. Rockhold (employee of owner) or (owner or operator) of the above-described well, being first duly sworn on oath, says: That I have knowledge of the facts, statements, and matters herein contained and the log of the above-described well and that the same are true and correct. So help me God.

(Signature) James W. Rockhold  
P. O. Box 221 Great Bend, Kansas  
(Address)

Subscribed and sworn to before me this 24 day of February, 1971

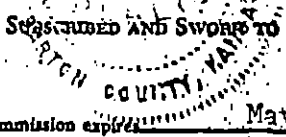

My commission expires May 27, 1973 Notary Public.

15-095-202290000

DRILLERS LOG

STUCKY NO. 1

CASING RECORD:	OPERATOR:	American Drilling Co.	DESCRIPTION:
8-5/8" @ 306'	CONTRACTOR:	Sage Drilling Co.	1030' FEL &
w/200 sax cement	COMMENCED:	December 27, 1970	296' FSL of NW/4
TOTAL DEPTH:	COMPLETED:	January 7, 1971	Sec. 30-29S-5W
4455'			Kingman County,
			Kansas

<u>FORMATION</u>	<u>FROM</u>	<u>TO</u>	<u>REMARKS</u>
Sand	0	50	
Shale & Red Bed	50	312	
Red Bed, Shale & Shells	312	890	
Shale & Lime	890	1250	
Lime & Shale	1250	2870	
Shale & Lime	2870	3130	
Lime & Shale	3130	3465	
Lime	3465	3855	
Lime & Shale	3855	4072	
Chert	4072	4125	
Lime	4125	4165	
Chert	4165	4275	
Lime	4275	4315	
Lime & Shale	4315	4375	
Lime	4375	4455	4 1/2" set @ 4446' w/75 sax cement

RECEIVED  
STATE CORPORATION COMMISSION  
FEB 2 1971  
CONSERVATION DIVISION  
Wichita, Kansas

I certify that this is a true and correct copy of the above log to the best of my knowledge.

SAGE DRILLING CO., INC.

BY Clarence Michael  
Clarence Michael



Subscribed and sworn to before me this 11th day of January, 1971.

Louise K. Whitted  
Louise K. Whitted, Notary Public

My commission expires:  
November 26, 1974.

JAN 28 1971  
JK