


WELL PLUGGING RECORD

Give All Information Completely  
Make Required Affidavit  
Mail or Deliver Report to:  
Conservation Division  
State Corporation Commission  
211 No. Broadway  
Wichita, Kansas

Kingman County, Sec. 18 Twp. 29S Rge. (E) 8 (W)  
Location as "NE/CNW/SW" or footage from lines SE SE NW  
Lease Owner Aurora Gasoline Company  
Lease Name Rohlman Well No. 1  
Office Address Roberts Hotel, Pratt, Kansas  
Character of Well (completed as Oil, Gas or Dry Hole) Dry Hole  
Date well completed May 1 19 56  
Application for plugging filed May 16 19 56  
Application for plugging approved May 18 19 56  
Plugging commenced May 19 19 56  
Plugging completed May 24 19 56  
Reason for abandonment of well or producing formation Dry Hole

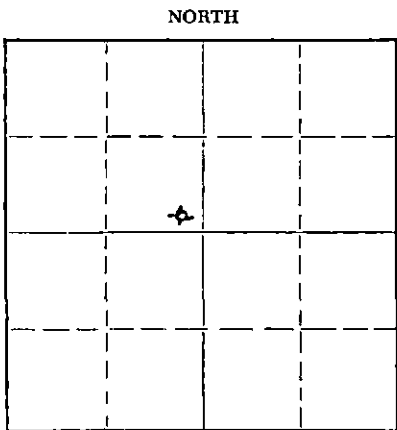

Locate well correctly on above Section Plat

If a producing well is abandoned, date of last production \_\_\_\_\_ 19 \_\_\_\_  
Was permission obtained from the Conservation Division or its agents before plugging was commenced? Yes

Name of Conservation Agent who supervised plugging of this well Mr. R. M. Brundage  
Producing formation \_\_\_\_\_ Depth to top 4156 Bottom \_\_\_\_\_ Total Depth of Well 4683 Feet  
Show depth and thickness of all water, oil and gas formations.

OIL, GAS OR WATER RECORDS

CASING RECORD

FORMATION	CONTENT	FROM	TO	SIZE	PUT IN	PULLED OUT
Mississippi	Water	4156	4171	5 1/2	4550	3281

Describe in detail the manner in which the well was plugged, indicating where the mud fluid was placed and the method or methods used in introducing it into the hole. If cement or other plugs were used, state the character of same and depth placed, from \_\_\_\_\_ feet to \_\_\_\_\_ feet for each plug set.

Set Halliburton Cast Iron Bridge Plug at 4025 feet and dumped 2 sacks cement; circulate hole with gel mud. Set plug at 120' dump 20 sacks cement; fill with mud to 35 feet; set plug 35 feet and dump 10 sacks cement to surface.

(If additional description is necessary, use BACK of this sheet)  
Name of Plugging Contractor Ace Pipe Pulling Company  
Address Great Bend, Kansas

STATE OF Kansas, COUNTY OF Sedgwick, ss.  
Leonard Olds (employee of owner) of the above-described well, being first duly sworn on oath, says: That I have knowledge of the facts, statements, and matters herein contained and the log of the above-described well as filed and that the same are true and correct. So help me God.

(Signature) Leonard Olds Leonard Olds  
Roberts Hotel, Pratt, Kansas  
(Address)

SUBSCRIBED AND SWORN TO before me this 28th day of May, 1956

My commission expires March 27, 1959  
Agnes M. Quinn AGNES M. QUINN Notary Public.

RECEIVED  
MAY 29 1956  
05-29-56  
CONSERVATION DIVISION  
Wichita, Kansas

PLUGGING  
FILE SEC 18 T 29 R 8W  
BOOK PAGE 62 LINE 19

Casing Record:

8 5/8" - 116' cemented with 120 sacks  
 5 1/2" - 4550'

Company: Aylward Drilling Company &  
 Aurora Gasoline Company

Contractor: Aylward Drilling Company

Commenced: May 30, 1955  
 Completed: June 19, 1955

Location:  
 SE SE NW  
 Sec. 18-29-8W  
 Kingman County, Kansas

Elevation:  
 1654 D.F.  
 1656 K.B.

	From	To	Remarks
Clay	0	35	JDST #1: 3295-3325, Open 1 hr. strong blow, recovered 845' salt water, BHFP 100#-410#, BHSIP 1250#/30 min. Hyd. 1930#/9.9# mud.
Sand & Gravel	35	65	
Red Rock	65	125	
Red Bed & Gravel	125	250	JDST #2 4158-4171, Open 1 hour. strong blow, gas to surface in 4 minutes, stabilized @ 1.8 MMCF in 40 min; recovered 40' gas cut mud / 90' watery mud, BHFP 350#-420#, BHSIP. 1490#/30 minutes, Hyd. 2260#/9.9# Mud.
Red Rock	250	420	
Red Rock & Shale	420	630	
Clay & Shale	630	840	JDST #3 4173-4201, Open 1 1/2 hours, strong to weak blow, recovered 3850' salt water, BHFP 800#-1600#, BHSIP 1600#/30 Min., Hyd 2240#/9.9 mud.
Clay & Shale	840	1107	
Lime & Shale	1107	1255	
Shale & Shells	1255	1265	JDST #4 4172-4180- Mirun (Hole bridged @ 420' off bottom)
Anhydrite	1265	1310	
Lime	1310	1515	
Shale & Lime	1515	3182	JDST #5 4172-4180- Mirun (Hole bridged @ 420' off bottom)
Sandy Lime	3182	3250	
Shale & Lime	3250	3320	
Sand	3320	3325	GEOLOGICAL TOPS:
Sand & Shale	3325	3415	
Sandy Lime & Shale	3415	3500	
Lime & Shale	3500	3520	Heebner 3255
Lime	3520	3587	Toronto 3280
Lime & Shale	3587	3634	Douglas 3298
Lime	3634	3892	Lansing 3485
Lime & Shale	3892	3927	Base Kansas City 3941
Shale & Lime	3927	4140	Des Moines-Marmaton 3969
Lime	4140	4153	Cherokee 4087
Mississippi Chat	4153	4171	Mississippi 4156
Mississippi Chat	4171	4201	Kinderhook Shale 4324
Mississippi Lime	4201	4208	Chattanooga 4441
Mississippi Lime	4208	4247	Viola 4468
Lime	4247	4280	Simpson 4511
Cherty Lime	4280	4307	Arbuckle 4633
Lime	4307	4325	Rotary Total Depth 4683
Shale & Lime	4325	4455	
Lime	4455	4481	
Shale & Lime	4481	4495	
Shale & Lime	4495	4515	
Sand	4515	4557	
Sand & Shale	4557	4617	
Shale	4617	4633	
Lime	4633	4661	
Shale & Lime	4661	4683	R.T.D.

I certify that this is a true and correct copy of the above log to the best of my knowledge.

*Paul W. Hesse*  
 Paul W. Hesse

Subscribed and sworn to before me this 23<sup>rd</sup> day of NOVEMBER, 1955

*Duane Jessup*  
 Notary Public

My Commission Expires: December 11, 1957.

PLUGGING  
 FILE SEC 18 T 29 R 8W  
 BOOK PAGE 62 LINE 19