

STATE OF KANSAS
STATE CORPORATION COMMISSION


Give All Information Completely
Make Required Affidavit
Mail or Deliver Report to:
Conservation Division
State Corporation Commission
212 No. Market
Wichita, Kansas

Form CP-4

15-095-20061-0000
WELL PLUGGING RECORD

Kingman County, Sec. 18 Twp. 29S Rge. 8 (E) (W) X

NORTH

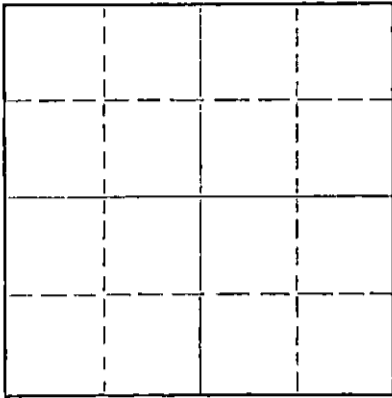

Locate well correctly on above
Section Plat

Location as "NE/CNW%SW%" or footage from lines C SE NE
Lease Owner Leben Drilling, Inc.
Lease Name Rohlman Well No. 1
Office Address P. O. Box 486 Great Bend, Kansas
Character of Well (completed as Oil, Gas or Dry Hole) _____
Date well completed _____ 19____
Application for plugging filed 7-12-68 19____
Application for plugging approved 2-13-68 19____
Plugging commenced 2-20-68 19____
Plugging completed 3-3-68 19____
Reason for abandonment of well or producing formation _____

If a producing well is abandoned, date of last production _____ 19____
Was permission obtained from the Conservation Division or its agents before plugging was commenced? Yes

Name of Conservation Agent who supervised plugging of this well Archie V. Elving
Producing formation _____ Depth to top _____ Bottom _____ Total Depth of Well 4207 Feet
Show depth and thickness of all water, oil and gas formations.

OIL, GAS OR WATER RECORDS

CASING RECORD

FORMATION	CONTENT	FROM	TO	SIZE	PUT IN	PULLED OUT
				8 5/8	209	None
				4 1/2	None	363 1/2
RECEIVED STATE CORPORATION COMMISSION MAR 6 - 1968 CONSERVATION DIVISION Wichita, Kansas						

Describe in detail the manner in which the well was plugged, indicating where the mud fluid was placed and the method or methods used in introducing it into the hole. If cement or other plugs were used, state the character of same and depth placed, from _____ feet to _____ feet for each plug set.

Moved in. Rigged up unit. Killed gas. Pumped 10 sacks of cement to 4100'.

Cleaned out cellar.

Working pipe. Broke off casing head and put on control head.

Working pipe. Shot pipe at 3650'. Cutting off yellow wrap. Pulling pipe.

Pulling pipe. Cutting off yellow wrap. Circulating mud.

Pulling pipe. Bailing hole down. Plugging well. Set rock bridge at 220' with 25 sacks of cement. Mud hole and rock bridge. Capped well with 10 sacks of cement.

(If additional description is necessary, use BACK of this sheet)

Name of Plugging Contractor Forbes Casing Pulling, Inc.
Address P. O. Box 221 Great Bend, Kansas

STATE OF Kansas, COUNTY OF Barton, ss.
J. O. Forbes (employee of owner) or (owner or operator) of the above-described

well, being first duly sworn on oath, says: That I have knowledge of the facts, statements, and matters herein contained and the log of the above-described well as filed and that the same are true and correct. (So help me God.)

(Signature) J. O. Forbes

P. O. Box 221 Great Bend, Kansas
(Address)

SUBSCRIBED AND SWORN to before me this 5 day of March, 19 68

My commission expires May 27, 1969

(Notary Signature)
Notary Public.

DRILLER'S LOG

COMPANY: TILCO etal
 CONTRACTOR: LEBEN DRILLING, INC.
 FARM: ROHLMAN #1
 LOCATION: C SE NE SECTION 18-29S-8W
 KINGMAN COUNTY, KANSAS
 COMMENCED: 12-22-67
 COMPLETED: 1-2-68

0	80	Clay, Shale
80	210	Redbed
210	540	Redbed, Shale
540	890	Shale
890	1320	Shale, Shells
1320	1330	Anhydrite
1330	1620	Shale, Shells
1620	2035	Lime, Shale
2035	2390	Shale, Lime
2390	2662	Lime, Shale
2662	2915	Shale, Lime
2915	3069	Lime, Shale
3069	3420	Shale, Lime
3420	3506	Sand
3506	3922	Lime
3922	3942	Sand
3942	4135	Lime
4135	4197	Lime, Sand
4197	4207	Chat
	<u>4207</u>	<u>RTD - Set 4 1/2" Casing</u>

8 5/8" 28# used surface casing set @ 209' cemented with 150 sacks
 Common, 2% cc

I, Leslie Kite, do hereby certify that the above and foregoing is
 a true and correct copy of the log of the Rohlman #1 Well, located
 C SE NE, Section 18, Township 29 South, Range 8 West, Kingman County,
 Kansas, as reflected by the records of Leben Drilling, Inc.

Leslie Kite
 Leslie Kite

STATE OF KANSAS)
) SS
 COUNTY OF BARTON)

Subscribed and sworn to and before me, a Notary Public, in
 and for Barton County, Kansas, this 5th day of January, 1968

Ulanda Nichols
 Ulanda Nichols

My Commission Expires:
 April 1, 1971

RECEIVED
 STATE CORPORATION COMMISSION
 FEB 15 1968
 CONSERVATION DIVISION
 Wichita, Kansas