


15-095-20062-0000

WELL PLUGGING RECORD

Give All Information Completely
Make Required Affidavit
Mail or Deliver Report to:
Conservation Division
State Corporation Commission
212 No. Market
Wichita, Kansas

NORTH

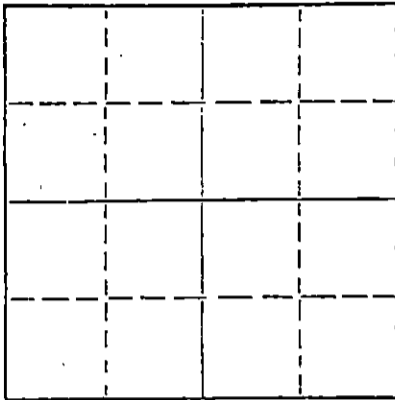

Locate well correctly on above
Section Plat

Kingman County, Sec. 21 Twp. 29S Rge. (E) 8W (W)
C SW SE
Location as "NE/CNW/SW" or footage from lines
Lease Owner Pickrell Drilling Company
Lease Name Hageman "E" Well No. 1
Office Address 705 4th Natl Bank Bldg, Wichita, Ks. 67202
Character of Well (completed as Oil, Gas or Dry Hole) Dry Hole
Date well completed January 13, 19 68
Application for plugging filed January 13, 19 68
Application for plugging approved January 13, 19 68
Plugging commenced January 13, 19 68
Plugging completed January 13, 19 68
Reason for abandonment of well or producing formation Dry Hole

If a producing well is abandoned, date of last production 19
Was permission obtained from the Conservation Division or its agents before plugging was commenced? Yes

Name of Conservation Agent who supervised plugging of this well Archie Elving
Producing formation Depth to top Bottom Total Depth of Well 4245 Feet
Show depth and thickness of all water, oil and gas formations.

OIL, GAS OR WATER RECORDS

CASING RECORD

FORMATION	CONTENT	FROM	TO	SIZE	PUT IN	PULLED OUT
				8 5/8"	217'	None

Describe in detail the manner in which the well was plugged, indicating where the mud fluid was placed and the method or methods used in introducing it into the hole. If cement or other plugs were used, state the character of same and depth placed, from feet to feet for each plug set.

Heavy mud to 200'. Set plug. Cemented with 25 sacks cement.
Heavy mud to 40'. Set plug. Cemented to bottom of cellar with
10 sacks cement. Plugged rat hole with 2 sacks cement.

RECEIVED
STATE CORPORATION COMMISSION
JAN 26 1968
CONSERVATION DIVISION
Wichita, Kansas

(If additional description is necessary, use BACK of this sheet)


Name of Plugging Contractor Pickrell Drilling Company
Address 705 Fourth National Bank Bldg., Wichita, Kansas 67202

STATE OF KANSAS COUNTY OF SEDGWICK ss.
C. W. Sebitts

(employee of owner) or (owner or operator) of the above-described well, being first duly sworn on oath, says: That I have knowledge of the facts, statements, and matters herein contained and the log of the above-described well as filed and that the same are true and correct. So help me God.

(Signature) C. W. Sebitts, Partner & Attorney-in-Fact
705 4th Natl Bank Bldg., Wichita, Ks. 67202
(Address)

Subscribed and sworn to before me this 16th day of January, 19 68

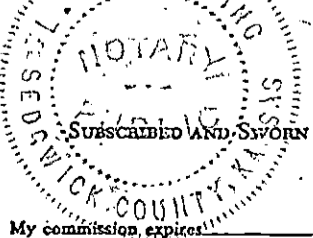

My commission expires May 10, 1970

L. M. Whiting
Notary Public.

ROTARY DRILLING LOG

COMPANY: Pickrell Drilling Company
705 Fourth National Bank Bldg.
Wichita, Kansas 67202

Rotary Drilling Commenced 1/4/68
Rotary Drilling Completed 1/13/68

LOCATION: Hageman "E" No. 1
C SW SE Section 21-29S-8W
Kingman County, Kansas

CONTRACTOR: **PICKRELL DRILLING COMPANY**
Wichita, Kansas

CASING RECORD: (11 jts.) 8 5/8" surface casing set at 217' and cemented with 160 sacks cement. Circ. Job complete at 7:00 PM, January 4, 1968. No oil string was run. D. & A., plugged January 13, 1968.

LOG

(Figures indicate bottom of formation — measurements from top of rotary bushing.)

40	Clay	C. F. S.
75	Clay and Sand	<u>4225'</u>
217	Red Rock and Cement	4245'
675	Red Rock and Shale	
1415	Shale	
2110	Shale and Lime	
2630	Shale	Slope Tests
3340	Shale and Lime	<u>3000'</u>
3483	Sandy Lime and Shale	3500'
3610	Lime and Shale	4000'
3670	Lime	
3742	Lime and Shale	
3963	Lime	
4135	Shale and Lime	S. L. M.
4225	Lime, Shale & Chert	<u>3543'</u> (No Corr.)
4245	Mississippian, RTD	

RECEIVED
STATE CORPORATION COMMISSION
JAN 26 1968
CONSERVATION DIVISION
Wichita, Kansas

The undersigned, C. W. Sebitts, Attorney-in-Fact for PICKRELL DRILLING COMPANY, hereby certifies in behalf of said Company, that the above is a true and correct log of the formation encountered in drilling the above well as reflected by the Daily Drilling Reports.

PICKRELL DRILLING COMPANY
By *C. W. Sebitts*
C. W. Sebitts Attorney-in-Fact

STATE OF KANSAS }
COUNTY OF SEDGWICK } ss.:

On this 16th day of January, 1968, before me the undersigned, a Notary Public, in and for the County and State aforesaid, personally appeared C. W. Sebitts, to me known to be the identical person who subscribed the name of PICKRELL DRILLING COMPANY to the foregoing instrument as its Attorney-in-Fact and acknowledged to me that he executed the same as his free and voluntary act and deed, and as the free and voluntary act and deed of such company, for the uses and purposes therein set forth.

Given under my hand and seal of office the day and year last above written.

My commission expires: May 10, 1970

L. M. Whiting
L. M. Whiting Notary Public

