

AUG 18 1982

CONSERVATION DIVISION  
Wichita, Kansas

15-095-2119-0000

Form CP-4

STATE OF KANSAS  
STATE CORPORATION COMMISSION


Give All Information Completely  
Make Required Affidavit  
Mail or Deliver Report to:  
Conservation Division  
State Corporation Commission  
211 No. Broadway  
Wichita, Kansas

WELL PLUGGING RECORD

Kingman County, Sec. 23 Twp. 29S Rge. 8 (W)

Location as "NE/CNW&SW" or footage from lines NW NE  
Lease Owner Monsanto Oil Company  
Lease Name Harner Well No. 1  
Office Address 3545 NW 58th St., Oklahoma City, Okla. 73112  
Character of Well (completed as Oil, Gas or Dry Hole) Dry Hole  
Date well completed 19  
Application for plugging filed April 14 19 82  
Application for plugging approved May 6 19 82  
Plugging commenced July 21 19 82  
Plugging completed July 27 19 82  
Reason for abandonment of well or producing formation Dry

NORTH

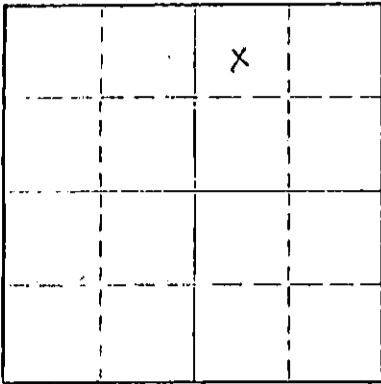

Locate well correctly on above  
Section Plat

If a producing well is abandoned, date of last production 19  
Was permission obtained from the Conservation Division or its agents before plugging was com-  
menced? Yes

Name of Conservation Agent who supervised plugging of this well  
Producing formation None Depth to top Bottom Total Depth of Well 4510 Feet  
Show depth and thickness of all water, oil and gas formations.

OIL, GAS OR WATER RECORDS

CASING RECORD

| FORMATION | CONTENT | FROM | TO | SIZE  | PUT IN | PULLED OUT |
|-----------|---------|------|----|-------|--------|------------|
|           |         |      |    | 8 5/8 | 267    | None       |
|           |         |      |    | 4 1/2 | 3467   | 2224'      |
|           |         |      |    |       |        |            |
|           |         |      |    |       |        |            |
Describe in detail the manner in which the well was plugged, indicating where the mud fluid was placed and the method or methods used in introducing it into the hole. If cement or other plugs were used, state the character of same and depth placed, from feet to feet for each plug set.

Hole was filled with heavy drilling mud. A 35 sack cement plug was placed from 3013' to 3413'. Shot and pulled 4 1/2" casing. Pumped 15 sacks Bentonite, 6 sacks hulls, 10 sacks Bentonite and 150 sacks cement with 3% Cal. Chloride down surface to squeeze. Cut off 8 5/8" surface pipe and welded on steel identification plate.

Name of Plugging Contractor Toland & Johnston, Inc. (If additional description is necessary, use BACK of this sheet)  
Address P. O. Box 94336, Oklahoma City, Oklahoma 73143

STATE OF Oklahoma, COUNTY OF Oklahoma, ss.  
Bruce E. Roll (employee of owner) or (owner or operator) of the above-described well, being first duly sworn on oath, says: That I have knowledge of the facts, statements, and matters herein contained and the log of the above-described well as filed and that the same are true and correct. So help me God.

(Signature) Bruce E. Roll  
3545 NW 58th St., Oklahoma City, Okla. 73112 (Address)

SUBSCRIBED AND SWORN to before me this 16th day of August, 19 82

My commission expires 9-13-83 Notary Public.