

STATE OF KANSAS  
STATE CORPORATION COMMISSION


15-095-10019-0000

WELL PLUGGING RECORD

Give All Information Completely  
File Required Affidavit  
Mail or Deliver Report to:  
Conservation Division  
State Corporation Commission  
211 No. Broadway  
Wichita, Kansas

Kingman County, Sec. 25 Twp. 29 Rge. 8 (X) (W)  
Location as "NE/CNW/SW" or footage from lines NW 1/4 SE 1/4 SE 1/4  
Lease Owner Drilling and Exploration Company, Inc.  
Lease Name Hemphill Well No. 1  
Office Address 811 Union Center, Wichita, Kansas  
Character of Well (completed as Oil, Gas or Dry Hole) Dry Hole  
Date well completed April 12, 1960  
Application for plugging filed April 12, 1960  
Application for plugging approved April 12, 1960  
Plugging commenced April 12, 1960  
Plugging completed April 12, 1960  
Reason for abandonment of well or producing formation Dry

NORTH

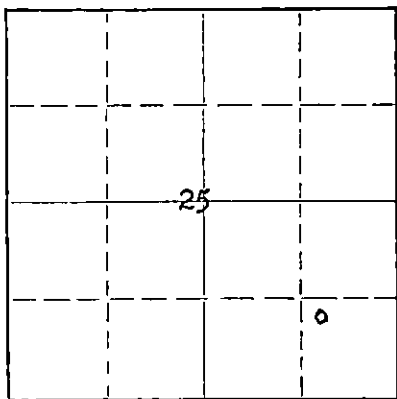

Locate well correctly on above  
Section Plat

If a producing well is abandoned, date of last production 19  
Was permission obtained from the Conservation Division or its agents before plugging was commenced? Yes

Name of Conservation Agent who supervised plugging of this well Fred Hampel  
Producing formation None Depth to top Bottom Total Depth of Well Feet  
Show depth and thickness of all water, oil and gas formations.

OIL, GAS OR WATER RECORDS

CASING RECORD

FORMATION	CONTENT	FROM	TO	SIZE	PUT IN	PULLED OUT
Sand & Shale	Water	0'	258'	8-5/8"	258'	None

Describe in detail the manner in which the well was plugged, indicating where the mud fluid was placed and the method or methods used in introducing it into the hole. If cement or other plugs were used, state the character of same and depth placed, from feet to feet for each plug set.

Filled with mud to 240'. Pushed plug and hulls to 240', pumped in 25 sacks cement on plug. Filled with mud to 35', pushed plug and hulls to 35'. Filled to surface with cement.

STATE CORPORATION COMMISSION

RCW  
04-26-60 APR 26 1960

CONSERVATION DIVISION  
Wichita, Kansas

(If additional description is necessary, use BACK of this sheet)  
Name of Plugging Contractor Mack Drilling Company  
Address Duncan, Oklahoma

STATE OF Kansas, COUNTY OF Sedgwick, ss.  
Karl A. Peterson (employee of owner) or (operator) of the above-described well, being first duly sworn on oath, says: That I have knowledge of the facts, statements, and matters herein contained and the log of the above-described well as filed and that the same are true and correct. So help me God.

(Signature) Karl A. Peterson  
811 Union Center, Wichita, Kansas  
(Address)

SUBSCRIBED AND SWORN TO before me this 21st day of April, 1960

My commission expires May 6, 1961 Elizabeth K. Sutton Notary Public.



*R*  
DRILLING AND EXPLORATION COMPANY, INC.

Dallas, Texas

DRILLERS WELL LOG

Hemphill #1

Commenced R.D.: 3-31-60

Completed R.D.: 4-12-60

Total Depth: 4300'

NW SE SE Sec. 25-29S-8W

Kingman County, Kansas

Elevations: 1560 K.B.

Initial Production: D&A

Contractor: Mack Oil Co.

Casing Record: 252' 8-5/8" OD surface casing

<u>STRATA</u>	<u>DEPTH</u>
Sand & Clay	0' - 371'
Shale	371' - 1074'
Anhydrite	1074' - 1340'
Lime	1340' - 2040'
Lime & Shale	2040' - 2183'
Shale & Shells	2183' - 2673'
Lime & Shale	2673' - 3000'
Sand & Shale	3000' - 3130'
Lime & Shale	3130' - 3265'
Sand	3265' - 3380'
Lime	3380' - 3445'
Shale & Lime	3445' - 3721'
Lime	3721' - 4194'
Lime & Chert	4194' - 4205'
Lime	4205' - 4300'

I hereby certify that the above is a true and correct log of said well as reflected by the daily drilling reports.

MACK OIL COMPANY

By Harold L. Steincamp  
Harold L. Steincamp

Signed and sworn to in my presence this 25th day of April, 1960, by Harold L. Steincamp, a representative of Mack Oil Company.

Elizabeth K. Sutton  
Elizabeth K. Sutton  
Notary Public

My Commission Expires: May 6, 1961

RECEIVED  
STATE CORPORATIONS COMMISSION

APR 26 1960

CONSERVATION DIVISION