


STATE OF KANSAS
STATE CORPORATION COMMISSION

15-095-19149-0000
WELL PLUGGING RECORD

Give All Information Completely
Make Required Affidavit
Mail or Deliver Report to:
Conservation Division
State Corporation Commission
211 No. Broadway
Wichita, Kansas

Kingman County. Sec. 28 Twp. 29 Rge. (E) 8 (W)
Location as "NE/CNW/SW" or footage from lines SW SW SE
Lease Owner A. G. Hill
Lease Name Higgins Well No. 1
Office Address Mercantile Bank Bldg., Dallas 1, Texas
Character of Well (completed as Oil, Gas or Dry Hole) Dry Hole
Date well completed 9-28-1958
Application for plugging filed 9-28-1958
Application for plugging approved 9-28-1958
Plugging commenced 9-28-1958
Plugging completed 9-28-1958
Reason for abandonment of well or producing formation Dry & Abandoned

NORTH

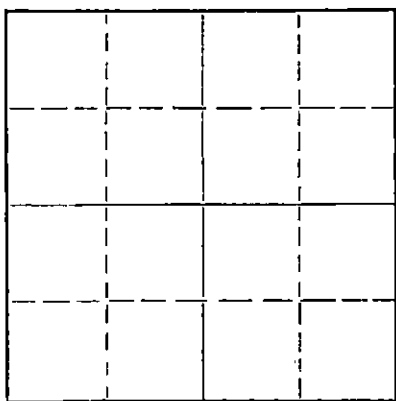

Locate well correctly on above
Section Plat

If a producing well is abandoned, date of last production 19
Was permission obtained from the Conservation Division or its agents before plugging was commenced? Yes

Name of Conservation Agent who supervised plugging of this well Bill DeCamp
Producing formation _____ Depth to top _____ Bottom _____ Total Depth of Well 4315 Feet
Show depth and thickness of all water, oil and gas formations.

OIL, GAS OR WATER RECORDS

CASING RECORD

FORMATION	CONTENT	FROM	TO	SIZE	PUT IN	PULLED OUT
				8-5/8"	250'	None

Describe in detail the manner in which the well was plugged, indicating where the mud fluid was placed and the method or methods used in introducing it into the hole. If cement or other plugs were used, state the character of same and depth placed, from _____ feet to _____ feet for each plug set.

Filled with heavy mud to 240' bridge hole and cement with 20 sacks cement.
Then heavy mud to 40' below ground level, bridge hole and cement with 10 sacks cement to bottom of cellar.

(If additional description is necessary, use BACK of this sheet)

Name of Plugging Contractor Pickrell Drilling Company
Address 705 Fourth National Bank Bldg., Wichita 2, Kansas

STATE OF KANSAS, COUNTY OF SEDGWICK, ss.
C. W. Sebitt (employee of owner) or (owner or operator) of the above-described well, being first duly sworn on oath, says: That I have knowledge of the facts, statements, and matters herein contained and the log of the above-described well as filed and that the same are true and correct. So help me God.

(Signature) *C. W. Sebitt*
705 Fourth Nat'l. Bank Bldg., Wichita, Kansas
(Address)

SUBSCRIBED AND SWORN to before me this 3rd day of October, 1958

My commission expires May 13, 1962
Mary Ellen Sampson
(Mary Ellen Sampson) Notary Public.

RECEIVED
STATE CORPORATION COMMISSION
10-04-58
OCT 4 1958

CONSERVATION DIVISION
Wichita, Kansas

PLUGGING
FILE SEC. 28 T. 29 R. 2W
BOOK PAGE 134 LINE 5

ROTARY DRILLING LOG

COMPANY: A. G. Hill

Rotary Drilling Commenced 9-17-58

LOCATION: SW SW SE Sec. 28-29S-8W
Kingman County, Kansas
HIGGINS #1

Rotary Drilling Completed 9-28-58

CONTRACTOR: PICKRELL DRILLING COMPANY
Wichita, Kansas

CASING RECORD: 8-5/8" surface casing set at 250' with 135 sacks cement, cement circulated.

LOG

(Figures indicate bottom of formation — measurements from top of rotary bushing.)

Red Rock & Shale	750'	Circ. for samples at	4260'
Shale	1250'		4270'
Lime	1285'		4280'
Lime & Shale	1675'		4290'
Lime	1820'		
Lime & Shale	2920'		
Lime	3035'		
Lime & Shale	3100'		
Lime & Hard Sand	3160'		
Lime & Shale	3290'		
Shale	3485'		
Lime & Shale	3542'		
Lime	3948'		
Lime & Shale	4249'		
Mississippi	4315'	T.D.	

S.L.M. at 1500' - O.K.
 2000' - O.K.
 2500' - O.K.
 3000' - O.K.
 3500' - O.K.

Slope Test at 1500' 0° off
 2500' 0° off
 3000' 0° off
 3500' 0° off

RECEIVED
STATE CORPORATION COMMISSION

OCT 4 1958

CONSERVATION DIVISION
Wichita, Kansas

PLUGGING
FILE SEC. 28 T. 29 R. 8W
BOOK PAGE 134 LINE 5

The undersigned, C. W. Sebitts, Attorney-in-Fact for PICKRELL DRILLING COMPANY, hereby certifies in behalf of said Company, that the above is a true and correct log of the formation encountered in drilling the above well as reflected by the Daily Drilling Reports.

PICKRELL DRILLING COMPANY

By C. W. Sebitts
Attorney-in-Fact

STATE OF KANSAS }
COUNTY OF SEDGWICK } ss.:

On this 3rd day of October, 1958, before me the undersigned, a Notary Public, in and for

the County and State aforesaid, personally appeared C. W. Sebitts, to me known to be the identical person who subscribed the name of PICKRELL DRILLING COMPANY to the foregoing instrument as its Attorney-in-Fact and acknowledged to me that he executed the same as his free and voluntary act and deed, and as the free and voluntary act and deed of such company, for the uses and purposes therein set forth.

Given under my hand and seal of office the day and year last above written.

My commission Expires: May 13, 1962

Mary Ellen Sampson
Notary Public
(Mary Ellen Sampson)