


STATE OF KANSAS
STATE CORPORATION COMMISSION

WELL PLUGGING RECORD

Give All Information Completely
Make Required Affidavit
Mail or Deliver Report to
Conservation Division
State Corporation Comm.
245 North Water
Wichita, KS 67202

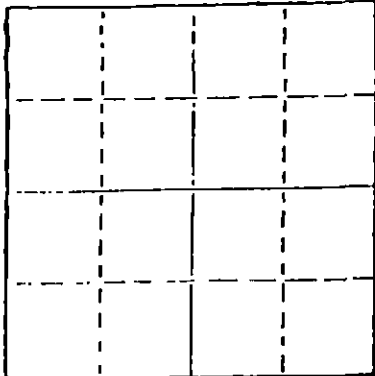

Locate well correctly on above
Section Plat

Hodgeman County, Sec. 25 Twp. 24S Rge. 22 ~~W~~
Location as "NE/CNW $\frac{1}{4}$ SW $\frac{1}{4}$ " or footage from lines
330' FSL & 330' FEL SE/4

Lease Owner HBP Enterprises, Inc.
Lease Name V.L. Katz Well No. #1
Office Address 2601 Ridgeway Plaza #2 Ft. Worth Tx. 76116
Character of Well (Completed as Oil, Gas or Dry Hole) Dry Hole.

Date Well completed 11-17 1981
Application for plugging filed 11-17 1981
Application for plugging approved 11-17 1981
Plugging commenced 11-17 1981
Plugging completed 11-17 1981
Reason for abandonment of well or producing formation _____

If a producing well is abandoned, date of last production _____ 19____

Was permission obtained from the Conservation Division or its agents before plugging was commenced? Yes

Name of Conservation Agent who supervised plugging of this well Clarence Thomas, Jr. Schmidt
Producing formation _____ Depth to top _____ Bottom _____ Total Depth of Well 4810'
Show depth and thickness of all water, oil and gas formations.

OIL, GAS OR WATER RECORDS

CASING RECORD

FORMATION	CONTENT	FROM	TO	SIZE	PUT IN	PULLED OUT
				8 5/8	548'	NONE

Describe in detail the manner in which the well was plugged, indicating where the mud fluid was placed and the method or methods used in introducing it into the hold. If cement or other plugs were used, state the character of same and depth placed, from _____ feet to _____ feet for each plug set.

Mud to 900', plug, 70 sx. cement.
Mud to 480', plug, 40 sx. cement.
Mud to 40', plug, 10 sx. cement.
5 sx. cement in rathole.

(If additional description is necessary, use BACK of this sheet)


Name of Plugging Contractor White & Ellis Drilling, Inc.
401 E. Douglas Suite 500 Wichita, Ks. 67202

STATE OF Kansas COUNTY OF Sedgwick, ss.
Ernest Sifford (employee of owner) or (owner or operator)
of the above-described well, being first duly sworn on oath, says: That I have knowledge of the facts, statements, and matters herein contained and the log of the above-described well as filed and that the same are true and correct. So help me God.

(Signature) Ernest Sifford
401 E. Douglas #500 Wichita, Ks. 67202
(Address)

SUBSCRIBED AND SWORN TO before me this 1st day of December, 1981

My commission expires

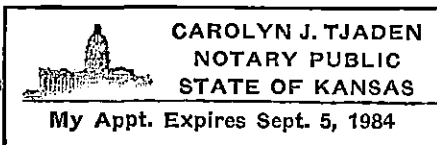

Carolyn J. Tjaden
Carolyn J. Tjaden - Notary Public.

RECEIVED
STATE CORPORATION COMMISSION

DEC - 2 1981

CONSERVATION DIVISION
Wichita, Kansas

DRILLERS LOG

OPERATOR: HBP Enterprises, Inc. 2601 Ridgeway Plaza #2 Fort Worth, Tx. 76116

CONTRACTOR: White & Ellis Drilling, Inc., Box 448, El Dorado, Kansas 67042

Lease Name V.L. Katz Well No. #1

Sec. 25 T. 24S R. 22W Spot 330' FSL & 330' FEL SE/4

County Hodgeman State Kansas Elevation _____

Casing Record:

Surface: 8 5/8 @ 548' with 300 Sxs. 3%cc
2%gel

Production: _____ @ _____ with _____ Sxs.

Type Well: D & A Total Depth 4810'

Drilling Commenced: 11-6-81 Drilling Completed 11-17-81

Formation	From	To	Tops
Cellar	0	0	
Shale, Lime	7	4810	

COMPLETION RECORD

Liner Record: Size _____ From _____ To _____

Cementing Record: _____ Sacks _____

Perforating Record:

Formation	Perforated Interval	Number Shots

Initial Production: _____

Electric Log	Type and Depths Covered