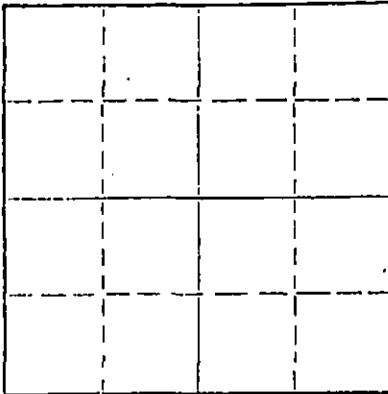


STATE OF KANSAS
STATE CORPORATION COMMISSION

Form CP-4

Give All Information Completely
Make Required Affidavit
Mail or Deliver Report to:
Conservation Division
State Corporation CommissionP. O. Box 17027
Wichita, Kansas 67217
NORTH

WELL PLUGGING RECORD

Locate well correctly on above
Section Plat

Hodgeman County, Sec. 31 Twp. 24S Rge. 22W (E) (W)
Location as "NE/CNW/SW" or footage from lines SW NE NE
Lease Owner Lightner Bros. Oil Co.
Lease Name Bollig Well No. 1
Office Address 219 N. Market, Wichita, Kansas
Character of Well (completed as Oil, Gas or Dry Hole) Dry Hole
Date well completed 9-22-1972
Application for plugging filed 9-22-1972
Application for plugging approved 9-22-1972
Plugging commenced 9-22-1972
Plugging completed 9-22-1972
Reason for abandonment of well or producing formation commercial quantity of oil not found
If a producing well is abandoned, date of last production 19
Was permission obtained from the Conservation Division or its agents before plugging was commenced? Yes

Name of Conservation Agent who supervised plugging of this well Ed Eves, Sublette
Producing formation Depth to top Bottom Total Depth of Well 4775 Feet
Show depth and thickness of all water, oil and gas formations.

OIL, GAS OR WATER RECORDS

CASING RECORD

FORMATION	CONTENT	FROM	TO	SIZE	PUT IN	PULLED OUT
				8-5/8"	346'	

Describe in detail the manner in which the well was plugged, indicating where the mud fluid was placed and the method or methods used in introducing it into the hole. If cement or other plugs were used, state the character of same and depth placed, from feet to feet for each plug set.

1st plug @ 850' w/80 sx.
2nd plug @ 340' w/30 sx.
Top plug @ 45' w/15 sx.

RECEIVED
STATE CORPORATION COMMISSION
SEP 27 1972
CONSERVATION DIVISION
Wichita, Kansas

(If additional description is necessary, use BACK of this sheet)
Name of Plugging Contractor Rains & Williamson Oil Co., Inc.
Address 435 Page Court Bldg. Wichita, Kansas

STATE OF Kansas COUNTY OF Sedgwick
Wilson Rains, President (employee of owner) or (owner or operator) of the above-described well, being first duly sworn on oath, says: That I have knowledge of the facts, statements, and matters herein contained and the log of the above-described well as filed and that the same are true and correct. So help me God.

(Signature) Wilson Rains
435 Page Court Bldg. Wichita, Ks.
(Address)

Subscribed and sworn to before me this 25th day of September, 1972



Juanita M. Green
Notary Public.

15-083-20237-00-00

WELL LOG


COMPANY Lightner Bros. Oil Co. /
 FARM Bollig NO. 1

SEC. 31 T. 24S R. 22W
 LOC. SW NE NE

RIG. NO. 1
 TOTAL DEPTH 4775'
 COMM. 9-12-72 COMP. 9-22-72

COUNTY Hodgeman
 KANSAS

CONTRACTOR Rains & Williamson Oil Co., Inc.

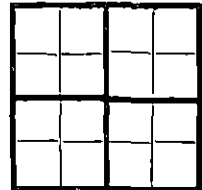

CASING
 20 10
 15 8 -5/8" @ 346' w/225 sxs., 2% gel,
 12 6 3% c.c.
 13 5

ELEVATION 2397 KB

PRODUCTION D&A

FIGURES INDICATE BOTTOM OF FORMATIONS

Post rock and shale	100
Shale	355
Shale and sand	650
Shale	995
Sand	1135
Red Bed and shale	1290
Red Bed	1529
Anhydrite	1570
Shale	1865
Shale w/lime streaks	2035
Shale and lime	2348
Lime and shale	2500
Shale and lime	2875
Lime and shale	3055
Shale and lime	3450
Lime and shale	3595
Shale and lime	3770
Lime and shale	3920
Lime	4775
Rotary Total Depth	4775

RECEIVED
 STATE CORPORATION COMMISSION
 SEP 27 1972
 CONSERVATION DIVISION
 Wichita, Kansas

State of Kansas
 County of Sedgwick } ss:

I, Wilson Rains, President of the Rains & Williamson Oil Co., Inc. Company

upon oath state that the above and foregoing is a true and correct copy of the log of the Bollig #1 well.

Wilson Rains
 WILSON RAINS

Juanita M. Green
 JUANITA M. GREEN
 NOTARY PUBLIC



Subscribed and sworn to before me this 25th day of September 19 72

My Commission Expires: 10-4-75