

15-083-20743-0000


STATE OF KANSAS  
STATE CORPORATION COMMISSION

WELL PLUGGING RECORD

Give All Information Completely  
Make Required Affidavit  
Mail or Deliver Report to  
Conservation Division  
State Corporation Comm.  
245 North Water  
Wichita, KS 67202

Hodgeman County, Sec. 35 Twp. 24s Rge. 22 E/W  
Location as "NE/CNW $\frac{1}{2}$ SW $\frac{1}{2}$ " or footage from lines \_\_\_\_\_  
C NE NE

Lease Owner Antares Oil Corporation  
Lease Name McKee Well No. 1  
Office Address 1546 Cole Blvd., Suite 220, Golden, CO  
Character of Well (Completed as Oil, Gas or Dry Hole) \_\_\_\_\_

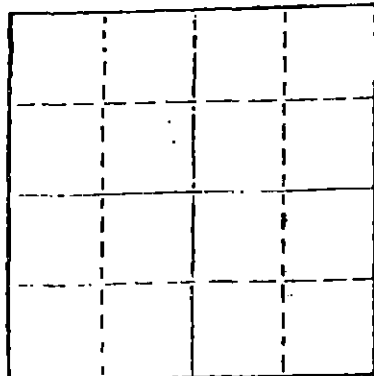

Locate well correctly on above  
Section Plot

Dry Hole  
Date Well completed 12-13 1980  
Application for plugging filed 12-13 1980  
Application for plugging approved 12-13 1980  
Plugging commenced 12-13 1980  
Plugging completed 12-13 1980  
Reason for abandonment of well or producing formation \_\_\_\_\_

If a producing well is abandoned, date of last production \_\_\_\_\_  
19

Was permission obtained from the Conservation Division or  
its agents before plugging was commenced? yes

Name of Conservation Agent who supervised plugging of this well Clarence Thomsas, Jr.  
Producing formation \_\_\_\_\_ Depth to top \_\_\_\_\_ Bottom \_\_\_\_\_ Total Depth of Well 4810'  
Show depth and thickness of all water, oil and gas formations.

OIL, GAS OR WATER RECORDS

CASING RECORD

FORMATION	CONTENT	FROM	TO	SIZE	PUT IN	PULLED OUT
				8 5/8"	355'	none

Describe in detail the manner in which the well was plugged, indicating where the mud fluid  
was placed and the method or methods used in introducing it into the hold. If cement or other  
plugs were used, state the character of same and depth placed, from \_\_\_\_\_ feet to  
\_\_\_\_\_ feet for each plug set,

- 60 sx cement @ 900'
- 35 sx cement @ 330'
- 10 sx cement @ 40'
- 5 sx cement in rathole.

(If additional description is necessary, use BACK of this sheet)

Name of Plugging Contractor White & Ellis Drilling, Inc.  
401 E. Douglas, Suite 500, Wichita, KS 67202

STATE OF KANSAS COUNTY OF SEDGWICK, ss.  
Ernest Sifford (employee of owner) or (owner or operator)  
of the above-described well, being first duly sworn on oath, says: That I have knowledge of  
the facts, statements, and matters herein contained and the log of the above-described well  
as filed and that the same are true and correct. So help me God.

(Signature) Ernest Sifford  
401 E. Douglas - Suite 500, Wichita, Ks.  
(Address) 67202

SUBSCRIBED AND SWORN TO before me this 29th day of December, 19 80.

My commission expires

CAROLYN J. TJADEN  
NOTARY PUBLIC  
STATE OF KANSAS  
My Appt. Expires Sept. 5, 1984

Carolyn J. Tjaden  
Carolyn J. Tjaden Notary Public.

RECEIVED  
STATE CORPORATION COMMISSION

DEC 30 1980

CONSERVATION DIVISION  
Wichita, Kansas

DRILLERS LOG

OPERATOR: Antares Oil Corporation, 1546 Cole Blvd., Suite 220, Golden, CO 80401  
CONTRACTOR: White & Ellis Drilling, Inc., Box 448, El Dorado, Kansas 67042

Lease Name McKee Well No. 1

Sec. 35 T. 24S R. 22W Spot C NE NE

County Hodgeman State Kansas Elevation \_\_\_\_\_

Casing Record:

Surface: 8 5/8" @ 355' with 225 <sup>3% cc</sup> 2% gel Sxs.

Production: \_\_\_\_\_ @ \_\_\_\_\_ with \_\_\_\_\_ Sxs.

Type Well: D & A Total Depth 4810'

Drilling Commenced: 12-4-80 Drilling Completed 12-13-80

Formation	From	To	Tops
Cellar	0	5	Anhydrite 1497
Shale	5	980	
Sand	980	1063	
Shale	1063	1500	
Shale, Lime	1500	1865	
Shale	1865	2380	
Shale, Lime	2380	3610	
Lime	3610	3785	
Shale, Lime	3785	4026	
Lime	4026	4310	
Shale, Lime	4310	4464	
Lime	4464	4810	

RECEIVED  
STATE CONSERVATION COMMISSION

DEC 30 1980

CONSERVATION DIVISION  
Wichita, Kansas

COMPLETION RECORD

Liner Record: Size \_\_\_\_\_ From \_\_\_\_\_ To \_\_\_\_\_

Cementing Record: \_\_\_\_\_ Sacks \_\_\_\_\_

Perforating Record:

Formation	Perforated Interval	Number Shots

Initial Production: \_\_\_\_\_

Electric Log \_\_\_\_\_ Type and Depths Covered \_\_\_\_\_  
\_\_\_\_\_  
\_\_\_\_\_