


STATE OF KANSAS
STATE CORPORATION COMMISSION

WELL PLUGGING RECORD

Give All Information Completely
Make Required Affidavit
Mail or Deliver Report to
Conservation Division
State Corporation Comm.
245 North Water
Wichita, KS 67202

Gray County, Sec. 2 Twp. 24S Rge. 30 West
Location as "NE/CNW $\frac{1}{4}$ SW $\frac{1}{4}$ " or footage from lines C SE NW

Lease Owner Seneca Oil Company
Lease Name Werner Well No. 1
Office Address 3013 N.W. 59th St. Okla. City, Okla. 73112
Character of Well (Completed as Oil, Gas or Dry Hole)

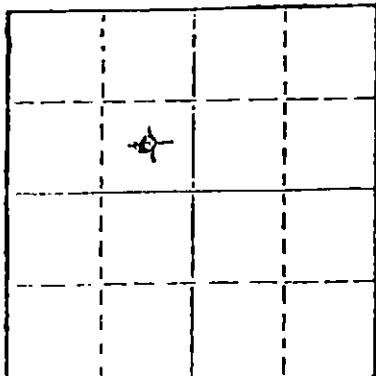

Locate well correctly on above
Section Plot

Dry Hole
Date Well completed 6/10 1976
Application for plugging filed 10/4 1976
Application for plugging approved 10/8 1976
Plugging commenced 10/25 1976
Plugging completed 10/28 1976
Reason for abandonment of well or producing formation
Dry Hole

If a producing well is abandoned, date of last production 19

Was permission obtained from the Conservation Division or its agents before plugging was commenced? Yes

Name of Conservation Agent who supervised plugging of this well Clarence Thomas
Producing formation Depth to top Bottom Total Depth of Well 4975'
Show depth and thickness of all water, oil and gas formations.

OIL, GAS OR WATER RECORDS

CASING RECORD

FORMATION	CONTENT	FROM	TO	SIZE	PUT IN	PULLED OUT
Morrow	Water	4783	88	8-5/8"	412	none
				4-1/2"	4974	3012

Describe in detail the manner in which the well was plugged, indicating where the mud fluid was placed and the method or methods used in introducing it into the hold. If cement or other plugs were used, state the character of same and depth placed, from feet to feet for each plug set.

Pump 1 sx of hulls & 10 sxs of cement from 4783' to 4683'

Pump 50 sxs of cement from 450 to 350

Put 15 sxs of cemnt from 40' to 0.

Cut off 8-5/8" - 3' below GL & cap w/plate.

RECEIVED
OIL COMMISSION
NOV 24 1976
CONSERVATION DIVISION
Wichita, Kansas

11-24-76

(If additional description is necessary, use BACK of this sheet)

Name of Plugging Contractor Sargents Casing Pulling Service Box 506, Liberal, Ks. 67901
Kansas #511

STATE OF Oklahoma COUNTY OF Oklahoma, ss.
Kenneth E. Bewley (employee of owner) or (owner or operator)
of the above-described well, being first duly sworn on oath, says: That I have knowledge of the facts, statements, and matters herein contained and the log of the above-described well as filed and that the same are true and correct. So help me God.

(Signature) Kenneth E. Bewley
Seneca Oil Company 3013 N.W. 59th Okla. City, Okla
(Address) 73112

SUBSCRIBED AND SWORN TO before me this 22nd day of November, 1976

[Signature]
Notary Public.

My commission expires 8/13/79

