


STATE OF KANSAS
STATE CORPORATION COMMISSION

WELL PLUGGING RECORD

Give All Information Completely
Make Required Affidavit
Mail or Deliver Report to
Conservation Division
State Corporation Comm.
245 North Water
Wichita, KS 67202

Gray County, Sec. 17 Twp. 24S Rge. 30W E/W
Location as "NE/CNW $\frac{1}{4}$ /SW $\frac{1}{4}$ " or footage from lines SE SE SW

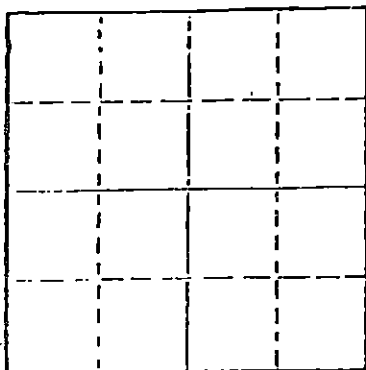

Locate well correctly on above
Section Plot

Lease Owner Beren Corporation
Lease Name Werner Well No. 1
Office Address 970 Fourth Financial Center
Character of Well (Completed as Oil, Gas or Dry Hole) _____

Dry Hole
Date Well completed 8/22/80 19
Application for plugging filed 8/22/80 19
Application for plugging approved 8/22/80 19
Plugging commenced 8/22/80 19
Plugging completed 8/22/80 19
Reason for abandonment of well or producing formation _____

Dry Hole
If a producing well is abandoned, date of last production _____ 19

Was permission obtained from the Conservation Division or its agents before plugging was commenced? Yes

Name of Conservation Agent who supervised plugging of this well _____
Producing formation _____ Depth to top _____ Bottom _____ Total Depth of Well 5200
Show depth and thickness of all water, oil and gas formations.

OIL, GAS OR WATER RECORDS

CASING RECORD

FORMATION	CONTENT	FROM	TO	SIZE	PUT IN	PULLED OUT
	Surface			8 5/8"	476'	None

Describe in detail the manner in which the well was plugged, indicating where the mud fluid was placed and the method or methods used in introducing it into the hold. If cement or other plugs were used, state the character of same and depth placed, from _____ feet to _____ feet for each plug set.

Plug @ 460' w/60 sx,
Plug @ 40' w/10 sx

9-3-80

RECEIVED
STATE CORPORATION COMMISSION

SEP 3 1980

(If additional description is necessary, use BACK of this report)
Name of Plugging Contractor Thunderbird Drilling, Inc. Conservation Division
Wichita, Kansas


STATE OF KANSAS COUNTY OF SEDGWICK, ss.
Burke Krueger (employee of owner) or (owner or operator)
of the above-described well, being first duly sworn on oath, says: That I have knowledge of the facts, statements, and matters herein contained and the log of the above-described well as filed and that the same are true and correct. So help me God.

(Signature) Burke Krueger
P.O. Box 18407- Wichita, Ks. 67218
(Address)

SUBSCRIBED AND SWORN TO before me this 29th day of August, 1980

Gloria DeJesus
Gloria DeJesus Notary Public.

My commission expires 3-25-84

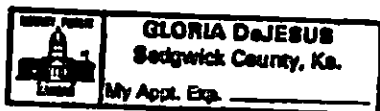

DRILLERS LOG

Company Thunderbird Drilling, Inc.

Contractor Thunderbird Drilling, I

Elevation 2874' K.B.

Farm Werner

Well No. 1

Casing 8 5/8" @ 476' w/300 sx

Location SE SE SW,
Sec. 17-24S-30W

County Gray County, Ks.

Production

<u>From</u>	<u>To</u>	<u>Description</u>
0	446	Surface Hole
446	735	Sand & shale
735	1100	Shale
1100	1432	Shale & sand & shells
1432	1550	Shale & Sand
1550	1710	Sand
1710	2026	Shale, Red bed & Sand
2026	2042	Anhydrite
2042	2160	Shale
2160	2570	Shale & Sand
2570	2760	Shale & Lime
2760	2805	Shale
2805	3000	Lime & Shale
3000	3370	Shale & Lime
3370	3565	Lime & Shale
3565	3735	Shale w/Lime strks.
3735	3930	Shale & Lime
3930	4360	Lime & Shale
4360	5200	Lime
5200	R.T.D.	

STATE OF KANSAS)
) ss.
COUNTY OF SEDGWICK)

RECEIVED
STATE CORPORATION COMMISSION
SEP - 3 1980
CONSERVATION DIVISION
Wichita, Kansas

I, Burke Krueger, of Thunderbird Drilling, Inc. upon oath states that the above and foregoing is a true and correct copy from the Daily Drilling Report from your Werner #1.

Burke Krueger

Subscribed and sworn to before me this 29th day of August, 1980

Gloria DeJesus
Gloria DeJesus Notary Public

My commission expires: 3-25-84

