


Give All Information Completely
Make Required Affidavit
Mail Deliver Report to:
Conservation Division
State Corporation Commission
211 No. Broadway
Wichita, Kansas

WELL PLUGGING RECORD

NORTH

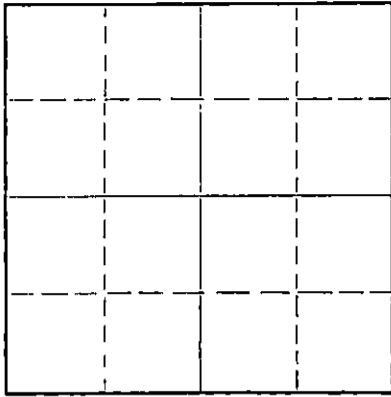

Locate well correctly on above
Section Plat

Hodgeman County, Sec. 7 Twp. 24S Rge. 23W (E) (W)
Location as "NE/CNW/SW" or footage from lines SW SW NE
Lease Owner -Kenneth Rupp John B. Hawley, Jr. Trust #1
Lease Name Jetmore Airport Well No. 1
Office Address 1035 Wichita Plaza, Wichita, Kansas
Character of Well (completed as Oil, Gas or Dry Hole) D&A
Date well completed February 12 19 64
Application for plugging filed February 12 19 64
Application for plugging approved February 12 19 64
Plugging commenced February 12 19 64
Plugging completed February 12 19 64
Reason for abandonment of well or producing formation D&A

If a producing well is abandoned, date of last production _____ 19____
Was permission obtained from the Conservation Division or its agents before plugging was commenced? Yes

Name of Conservation Agent who supervised plugging of this well Hugh Scott
Producing formation _____ Depth to top _____ Bottom _____ Total Depth of Well 4871 Feet
Show depth and thickness of all water, oil and gas formations.

OIL, GAS OR WATER RECORDS

CASING RECORD

FORMATION	CONTENT	FROM	TO	SIZE	PUT IN	PULLED OUT
				8 5/8"	276.68	-0-

Describe in detail the manner in which the well was plugged, indicating where the mud fluid was placed and the method or methods used in introducing it into the hole. If cement or other plugs were used, state the character of same and depth placed, from _____ feet to _____ feet for each plug set.

Set plug @ 700' w/25 sx
cement, set plug @ 276'
25 sx cement, set plug @ 40'
15 sx cement.

RECEIVED
STATE CORPORATION COMMISSION

FEB 18 1964

2-18-64

CONSERVATION DIVISION
Wichita, Kansas

(If additional description is necessary, use BACK of this sheet)

Name of Plugging Contractor Red Tiger Drilling Company
Address Box 173--Russell, Kansas

STATE OF KANSAS, COUNTY OF SEDGWICK, ss.
George A. Angle (employee or owner) of the above-described well, being first duly sworn on oath, says: That I have knowledge of the facts, statements, and matters herein contained and the log of the above-described well as filed and that the same are true and correct. So help me God.

(Signature) George A. Angle
1720 Wichita Plaza, Wichita, Kansas
(Address)

SUBSCRIBED AND SWORN to before me this 13th day of February, 1964

My commission expires 11-17-66

Maguire V. Head
Notary Public.

DRILLERS LOG

#1 Jetmore Airport
 John B. Hawley, Jr. Trust No. 1
 CASING RECORD: COMPANY: ~~Keane~~ ~~Supp~~ DESCRIPTION:
 8 5/8" @ 276.63' CONTRACTOR: Red Tiger Drilling SW SW NE
 w/235 sx cement. COMMENCED: January 30, 1964 7-24-23, Hodgeson Co.,
 Kansas
 COMPLETED: February 12, 1964 ELEVATION: 2462 DF
 2463 RB
 TOTAL DEPTH: 2-12-64

<u>FORMATION</u>	<u>FROM</u>	<u>TO</u>	<u>REMARKS</u>
Shale & Lime	0	278	
Shale & Shells	278	999	
Blane Anhydrite	999	1016	
Shale Shells & RedBed	1016	1105	
Sand	1105	1280	
Shale & Shells	1280	1405	
Shale Shells & Redbed	1405	1606	
Anhydrite	1606	1641	
Shale & Shells	1641	2215	
Lime & Shale	2215	2850	
Lime	2850	3280	
Lime & Shale	3280	4035	
Lime	4035	4715	
Lime & Chert	4715	4860	
Lime	4860	4871	

RECEIVED
 STATE CORPORATION COMMISSION

FEB 18 1964

CONSERVATION DIVISION
 Wichita, Kansas

I certify that this a true and correct copy of the above log to the best of my knowledge.

RED TIGER DRILLING COMPANY

George A. Angle
 George A. Angle

Subscribed and sworn to before me this 13th day of February, 1964.

D. Wayne V. Head
 Notary Public

My Commission Expires:

11-17-66