

STATE OF KANSAS  
STATE CORPORATION COMMISSION

Form CP-4

Give All Information Completely  
Make Required Affidavit  
Mail or Deliver Report to:  
Conservation Division  
State Corporation Commission  
212 No. Market  
Wichita, Kansas

WELL PLUGGING RECORD

Hodgeman County, Sec. 10 Twp. 24S Rge. 23 (X) (W)

Location as "NE/CNW/SW" or footage from lines C NW SW

Lease Owner Beardmore Drilling Company

Lease Name ERICKSON Well No. 1

Office Address 700 One-Twenty Building

Character of Well (completed as Oil, Gas or Dry Hole) Dry Hole

Date well completed 4-5 19 67

Application for plugging filed 4-5 19 67

Application for plugging approved 4-5 19 67


Plugging commenced 4-5 19 67

Plugging completed 1:00 A.M. 4-6 19 67

Reason for abandonment of well or producing formation No oil or gas found in commercial quantities.

If a producing well is abandoned, date of last production -- 19 --

Was permission obtained from the Conservation Division or its agents before plugging was commenced? Yes

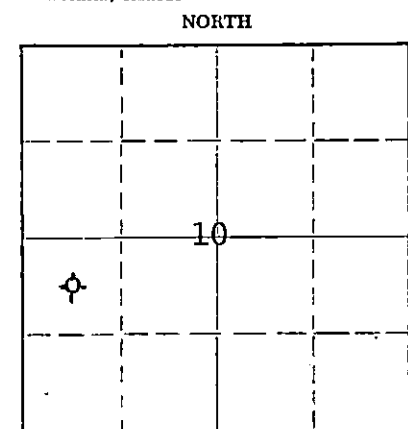

Locate well correctly on above Section Plat

Name of Conservation Agent who supervised plugging of this well Ed Eaves, Liberal, Kansas

Producing formation None Depth to top Bottom Total Depth of Well 4768 Feet

Show depth and thickness of all water, oil and gas formations.

OIL, GAS OR WATER RECORDS

CASING RECORD

FORMATION	CONTENT	FROM	TO	SIZE	PUT IN	PULLED OUT
				8-5/8"	316'	-0-

Describe in detail the manner in which the well was plugged, indicating where the mud fluid was placed and the method or methods used in introducing it into the hole. If cement or other plugs were used, state the character of same and depth placed, from feet to feet for each plug set.

Spotted 30 sacks cement at 700'. Mud back to 366' and spot 30 sacks. Mud back to 45', set solid bridge and capped with 15 sacks; 2 sacks in rat hole.

RECEIVED  
STATE CORPORATION COMMISSION

APR 14 1967

CONSERVATION DIVISION  
Wichita, Kansas

(If additional description is necessary, use BACK of this sheet)  
Name of Plugging Contractor Rains & Williamson Oil Co., Inc.  
Address 1425 Wichita Plaza Bldg. - Wichita, Kansas

STATE OF KANSAS, COUNTY OF SEDGWICK, ss.  
Wilson Rains (employee of owner) or (owner) of the above-described

well, being first duly sworn on oath, says: That I have knowledge of the facts, statements, and matters herein contained and the log of the above-described well as filed and that the same are true and correct. So help me God.

(Signature) Wilson Rains Wilson Rains

1425 Wichita Plaza - Wichita, Kansas

(Address)

SUBSCRIBED AND SWORN TO before me this 10 day of April, 19 67

Mary J. Brown  
Mary J. Brown Notary Public.

My commission expires March 3, 1970

ROTARY DRILLING LOG

Operator: Beardmore Drilling Company  
 #1 ERICKSON, C NW SW  
 Section 10-24S-23W  
 Hodgeman County, Kansas

Contractor: Rains & Williamson  
 Oil Co., Inc.  
 Commenced: 3-25-67  
 Completed: 4-5-67

Remarks: Set 8-5/8" sur-  
 face casing at  
 316' w/200 sacks  
 common w/2% Ca.Cl.

## Formations:

Post Rock	30'
Shale and Shells	318'
Shale and Red Bed	630'
Sand	700'
Shale	825'
Red Bed	957'
Anhydrite	970'
Shale and Red Bed	1060'
Sand	1199'
Shale and Red Bed	1618'
Anhydrite	1634'
Shale and Shells	2125'
Lime and Shale	2400'
Lime	2560'
Lime and Shale	2755'
Lime	2975'
Lime and Shale	3016'
Lime, Shale and Chalk	3165'
Lime and Shale	4190'
Lime	4768'
Rotary Total Depth (D & A)	4768'

RECEIVED  
 STATE CONSERVATION COMMISSION

APR 14 1967


CONSERVATION DIVISION  
 Topeka, Kansas

We certify the above log is  
 true and correct to the best  
 of our knowledge and belief.

RAINS & WILLIAMSON OIL CO., INC.

  
 Wilson Rains

Subscribed to and sworn before me, a Notary Public within and for the State  
 of Kansas, County of Sedgwick, this 10th day of April, 1967.

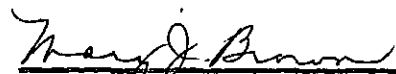  
 Mary J. Brown Notary Public

My Commission Expires:  
 March 3, 1970