

CARD MUST BE TYPED

State of Kansas
NOTICE OF INTENTION TO DRILL
(see rules on reverse side)

CARD MUST BE SIGNED

Starting Date: Approx. July 30, 1985
month day year

API Number 15- 083-21,204-0000
 East

OPERATOR: License # 4043

... NWNW ... Sec 19 Twp 24 S, Rge 22 West
(location)

Name Denver-Alaska Oil Company

Address 350 Indiana St., Suite 410

City/State/Zip Golden, CO 80401

Contact Person John Rakowski

Phone (303) 278-4814

4620 Ft North from Southeast Corner of Section

4620 Ft West from Southeast Corner of Section

(Note: Locate well on Section Plat on reverse side)

CONTRACTOR: License #

Nearest lease or unit boundary line 660 feet.

County Hodgeman

Name To be determined

Lease Name James P. Mooney Well# 1

City/State

Domestic well within 330 feet: yes no

Well Drilled For: Well Class: Type Equipment:

Municipal well within one mile: yes no

- Oil Swd Infield Mud Rotary
- Gas Inj Pool Ext. Air Rotary
- OWWO Expl Wildcat Cable

Depth to Bottom of fresh water Approx. 250 feet

Lowest usable water formation Dakota Sandstone Cheyenne

If OWWO: old well info as follows:

Depth to Bottom of usable water Approx. ~~250~~ 600 feet

Operator

Surface pipe by Alternate: 1 ~~2~~

Well Name

Surface pipe to be set Approx. 350 feet

Comp Date Old Total Depth

Conductor pipe if any required None feet

Projected Total Depth 4800 feet

Ground surface elevation Approx. 2340 feet MSL

Projected Formation at TD Mississippian

This Authorization Expires 1-17-86

Expected Producing Formations Mississippian

Approved By 7-17-85

I certify that we will comply with K.S.A. 55-101, et seq., plus eventually plugging hole to K.C.C. specifications.

Date 7-12-85 Signature of Operator or Agent Ann J. Donnelly


Title Vice President

RECEIVED
STATE CORPORATION COMMISSION

Must be filed with the K.C.C. five (5) days prior to commencing well
This card void if drilling not started within six (6) months of date received by K.C.C.

JUL 17

CONSERVATION DIVISION
Wichita, Kansas
A Regular Section of Land
1 Mile = 5,280 Ft.

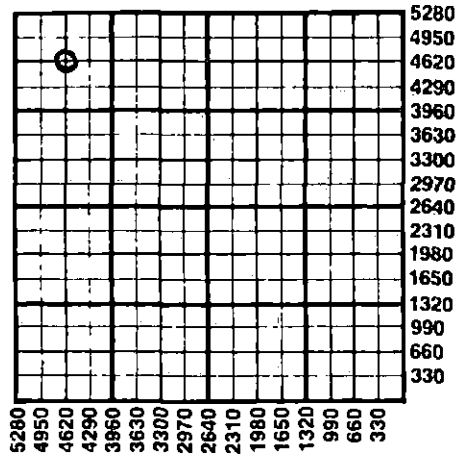

Important procedures to follow:

1. Notify District office before setting surface casing.
2. Set surface casing by circulating cement to the top.
3. File completion forms ACO-1 with K.C.C. within 90 days of well completion, following instructions on ACO-1, side 1, and including copies of wireline logs.
4. Notify District office 48 hours prior to old well workover or re-entry.
5. Prior to plugging, prepare a plugging plan, then obtain agreement from the appropriate district office for an approved plugging plan.
6. Submit plugging report (CP-4) to K.C.C. after plugging is completed.
7. Obtain an approved injection docket number before disposing of salt water.
8. Notify K.C.C. within 10 days when injection commences or terminates.
9. If an alternate 2 completion, cement in the production pipe from below any usable water to surface within 120 days of spud date.

State Corporation Commission of Kansas
Conservation Division
200 Colorado Derby Building
Wichita, Kansas 67202
(316) 263-3238