

**"CORRECTED"**

CARD MUST BE TYPED

State of Kansas  
**NOTICE OF INTENTION TO DRILL**  
(see rules on reverse side)

*COLLECTION*  
CARD MUST BE SIGNED

8-27-85

Starting Date: August 30, 1985  
month day year

API Number 15- 15-095-21,540 0000

Approx.  East

C. NW. NW. . . . Sec 31. Twp 29. S, Rge 8. . .  West  
(location)

OPERATOR: License # 5041  
Name Ram Petroleum Corporation  
Address 1260 KSB Bldg.  
City/State/Zip Wichita, Kansas 67202  
Contact Person Jon M. Callen  
Phone 265-5241

\* 4620 Ft North from Southeast Corner of Section  
\* 4620 Ft West from Southeast Corner of Section  
(Note: Locate well on Section Plat on reverse side)

CONTRACTOR: License # 5107  
Name H-30, Inc.  
City/State Wichita, Kansas 67202

Nearest lease or unit boundary line 660 feet.

County Kingman

Lease Name Cornelius Well# 1

Domestic well within 330 feet:  yes  no

Municipal well within one mile:  yes  no

Well Drilled For: Well Class: Type Equipment:  
 Oil  Swd  Infield  Mud Rotary  
 Gas  Inj  Pool Ext.  Air Rotary  
 OWWO  Expl  Wildcat  Cable

Depth to Bottom of fresh water 60' feet

Lowest usable water formation

Depth to Bottom of usable water 200' feet

Surface pipe by Alternate: 1  2

Surface pipe to be set 350' feet

Conductor pipe if any required

Ground surface elevation 1639' feet MSL

This Authorization Expires 1-16-86

Approved By 7-16-85

If OWWO: old well info as follows:

Operator  
Well Name  
Comp Date Old Total Depth  
Projected Total Depth 4250' feet  
Projected Formation at TD Mississippi  
Expected Producing Formations Mississippi

\*WQS: SE NW NW 4290 FSL  
4290 FEL  
Geologist

I certify that we will comply with K.S.A. 55-101, et seq., plus eventually plugging hole to K.C.C. specifications.

Date Aug. 26, 1985 Signature of Operator or Agent

*Jon M. Callen*  
Jon M. Callen Title

Must be filed with the K.C.C. five (5) days prior to commencing well  
This card void if drilling not started within six (6) months of date received by K.C.C.


CONSERVATION DIVISION  
Wichita, Kansas

**Important procedures to follow :**

A Regular Section of Land

1 Mile = 5,280 Ft.

RECEIVED  
STATE CORPORATION COMMISSION  
58-42-80  
AUG 27

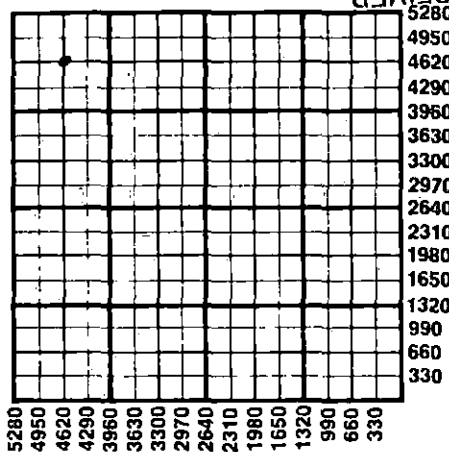

1. Notify District office before setting surface casing.
2. Set surface casing by circulating cement to the top.
3. File completion forms ACO-1 with K.C.C. within 90 days of well completion, following instructions on ACO-1, side 1, and including copies of wireline logs.
4. Notify District office 48 hours prior to old well workover or re-entry.
5. Prior to plugging, prepare a plugging plan, then obtain agreement from the appropriate district office for an approved plugging plan.
6. Submit plugging report (CP-4) to K.C.C. after plugging is completed.
7. Obtain an approved injection docket number before disposing of salt water.
8. Notify K.C.C. within 10 days when injection commences or terminates.
9. If an alternate 2 completion, cement in the production pipe from below any usable water to surface within 120 days of spud date.

State Corporation Commission of Kansas  
Conservation Division  
200 Colorado Derby Building  
Wichita, Kansas 67202  
(316) 263-3238