

CARD MUST BE TYPED

State of Kansas

CARD MUST BE SIGNED

NOTICE OF INTENTION TO DRILL

(see rules on reverse side)

15-095-21590-0000 ✓ G

Expected Spud Date. 5 25 88 month day year

API Number 15-095-21590

OPERATOR: License # 5123
Name Pickrell Drilling Company, Inc.
Address 110 N. Market, Suite 205
City/State/Zip Wichita, KS 67202
Contact Person Jay McNeil
Phone 262-8427

W 1/2 E 1/2 X NW NW Sec 24 Twp. 29S S, Rg. 8 X East West
4620 Ft. from South Line of Section
4490 Ft. from East Line of Section

(Note: Locate well on Section Plat on reverse side)

CONTRACTOR: License # 5123
Name Pickrell Drilling Company, Inc.
City/State Wichita, KS

Nearest lease or unit boundary line. 660 feet
County Kingman

Lease Name Young "JJ" Unit Well # 2
Ground surface elevation 1597 feet MSL

Well Drilled For: Well Class: Type Equipment:
X Oil Storage X Infield X Mud Rotary
X Gas Inj Pool Ext Air Rotary
OWWO Expl Wildcat Cable

Domestic well within 330 feet: yes X no
Municipal well within one mile: yes X no

If OWWO: old well info as follows:

Depth to bottom of fresh water. 60
Depth to bottom of usable water 120

Operator
Well Name
Comp Date Old Total Depth

Surface pipe by Alternate: 1 X 2
Surface pipe planned to be set 200+ feet

I certify that well will comply with K.S.A. 55-101, et seq., plus eventually plugging hole to KCC specifications.

Conductor pipe required
Projected Total Depth 4300 feet

Date May 20, 1988 Signature of Operator or Agent

Formation Mississippian

Title Chief Geologist

For KCC Use:

Conductor Pipe Required feet; Minimum Surface Pipe Required 200 feet per Alt. 1 X
This Authorization Expires 11-20-88 Approved By DC 5-20-88


EFFECTIVE DATE: 5-25-88

Must be filed with the K.C.C. five (5) days prior to commencing well
This card void if drilling not started within six (6) months of date received by K.C.C.

Important procedures to follow:

1. Notify District office before setting surface casing.
2. Set surface casing by circulating cement to the top.
3. File completion forms ACO-1 with K.C.C. within 120 days of well spud date, following instructions on ACO-1, side 1, and including copies of wireline logs.
4. Notify District office 48 hours prior to old well workover or re-entry.
5. Prior to filing Intent, prepare a proposed plugging plan in case well is D & A, then obtain approval of plan when calling district office prior to setting surface pipe.
6. Submit plugging report (CP-4) to K.C.C. after plugging is completed.
7. Obtain an approved injection docket number before disposing of salt water.
8. Notify K.C.C. within 10 days when injection commences or terminates.
9. If an alternate 2 completion, cement in the production pipe from below any usable water to surface within 120 days of spud date.

A Regular Section of Land
1 Mile = 5,280 Ft.

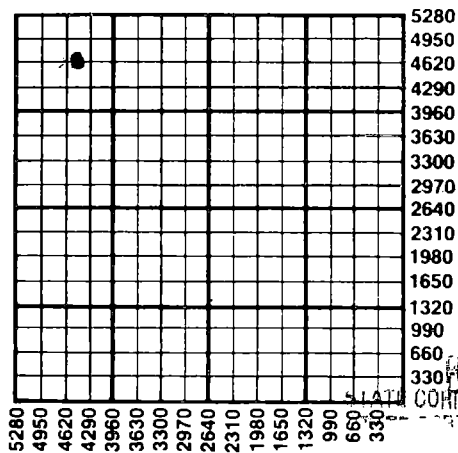

MAY 20 1988

CONSERVATION DIVISION
Wichita, Kansas

State Corporation Commission of Kansas
Conservation Division
200 Colorado Derby Building
Wichita, Kansas 67202-1212
(316) 263-3238