

CARD MUST BE TYPED

State of Kansas
NOTICE OF INTENTION TO DRILL

CARD MUST BE SIGNED

(see rules on reverse side)

Starting Date: JULY 12 1984
month day year

API Number 15- 095-21,469-000
CENTER S/2
SW NW (location) Sec 31 Twp 29 S, Rge 5 East West

OPERATOR: License # 5430
Name ENERGY THREE, INC.
Address P. O. Box 1505
City/State/Zip GREAT BEND, KS. 67530
Contact Person DOUGLAS MEYER
Phone AC316-792-5968

2970 Ft North from Southeast Corner of Section
4620 Ft West from Southeast Corner of Section
(Note: Locate well on Section Plat on reverse side)

CONTRACTOR: License # 5840
Name BRANDT DRILLING CO., INC.
City/State WICHITA, KANSAS 67202

Nearest lease or unit boundary line 660 feet.
County KINGMAN
Lease Name EWING Well# 1
Domestic well within 330 feet: yes no
Municipal well within one mile: yes no

Well Drilled For: Well Class: Type Equipment:
 Oil Swd Infield Mud Rotary
 Gas Inj Pool Ext. Air Rotary
 OWWO Expl Wildcat Cable

Depth to Bottom of fresh water 4.5 mHC feet
Lowest usable water formation ~~Missouri~~
Depth to Bottom of usable water 200 feet
Surface pipe by Alternate: 1 2
Surface pipe to be set 200 feet
Conductor pipe if any required feet
Ground surface elevation feet MSL.
This Authorization Expires 11/9/85
Approved By 7/9/84 R

If OWWO: old well info as follows:
Operator
Well Name
Comp Date Old Total Depth
Projected Total Depth 4500 feet
Projected Formation at TD VIOLA
Expected Producing Formations VIOLA

I certify that we will comply with K.S.A. 55-101, et seq., plus eventually plugging hole to K.C.C. specifications.


Date 7-6-84 Signature of Operator or Agent Douglas P Meyer Title EXEC. VICE-PRES.

MHC/KIOHE 7-9-84 Form C-1 4/84

Must be filed with the K.C.C. five (5) days prior to commencing well
 This card void if drilling not started within six (6) months of date received by K.C.C.

Important procedures to follow :

**A Regular Section of Land
 1 Mile = 5,280 Ft.**

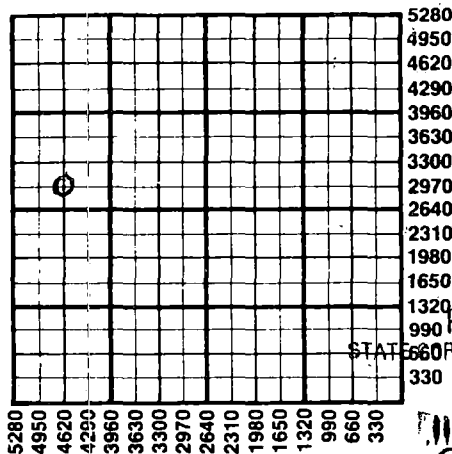

1. Notify District office before setting surface casing.
 2. Set surface casing by circulating cement to the top.
 3. File completion forms ACO-1 with K.C.C. within 90 days of well completion, following instructions on ACO-1, side 1, and including copies of wireline logs.
 4. Notify District office 48 hours prior to old well workover or re-entry.
 5. Prior to plugging, prepare a plugging plan, then obtain agreement from the appropriate district office for an approved plugging plan.
 6. Submit plugging report (CP-4) to K.C.C. after plugging is completed.
 7. Obtain an approved injection docket number before disposing of salt water.
8. Notify K.C.C. within 10 days when injection commences or terminates.
9. In an alternate 2 completion, cement in the production pipe from below any usable water to surface within 120 days of spud date.

RECEIVED
 STATE CORPORATION COMMISSION
 CONSERVATION DIVISION
 WICHITA, KANSAS
 JUL 09 1984
 07-09-84

State Corporation Commission of Kansas
 Conservation Division
 200 Colorado Derby Building
 Wichita, Kansas 67202
 (316) 263-3238